


RECEIVED
JUL 29 1980
WATER RESOURCES DEPT
SALEM, OREGON

Forked Horn Springs

water source

APR 6 1981
WATER RESOURCES DEPT
SALEM, OREGON

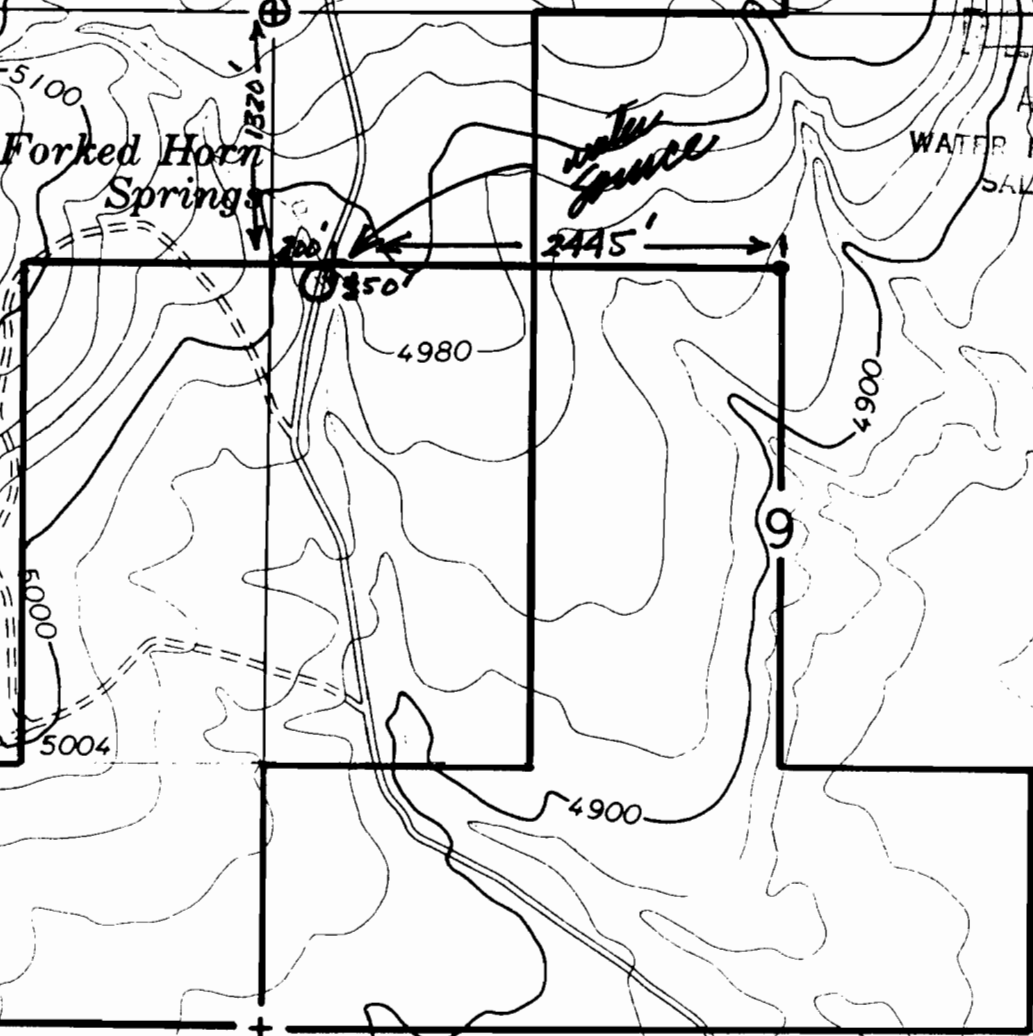

Application No. 64721
Permit No. 45720

1" = 1000'

T28S R7E. W.M.

3

7

16

960

4796

RECEIVED

MAY 19 1981

R 7 E

R 8 E

R 8 E


R 9 E

WATER RESOURCES DEPT
SALEM, OREGON

WATER RESOURCES DEPT
SALEM, OREGON

T 25 S

T 27 S

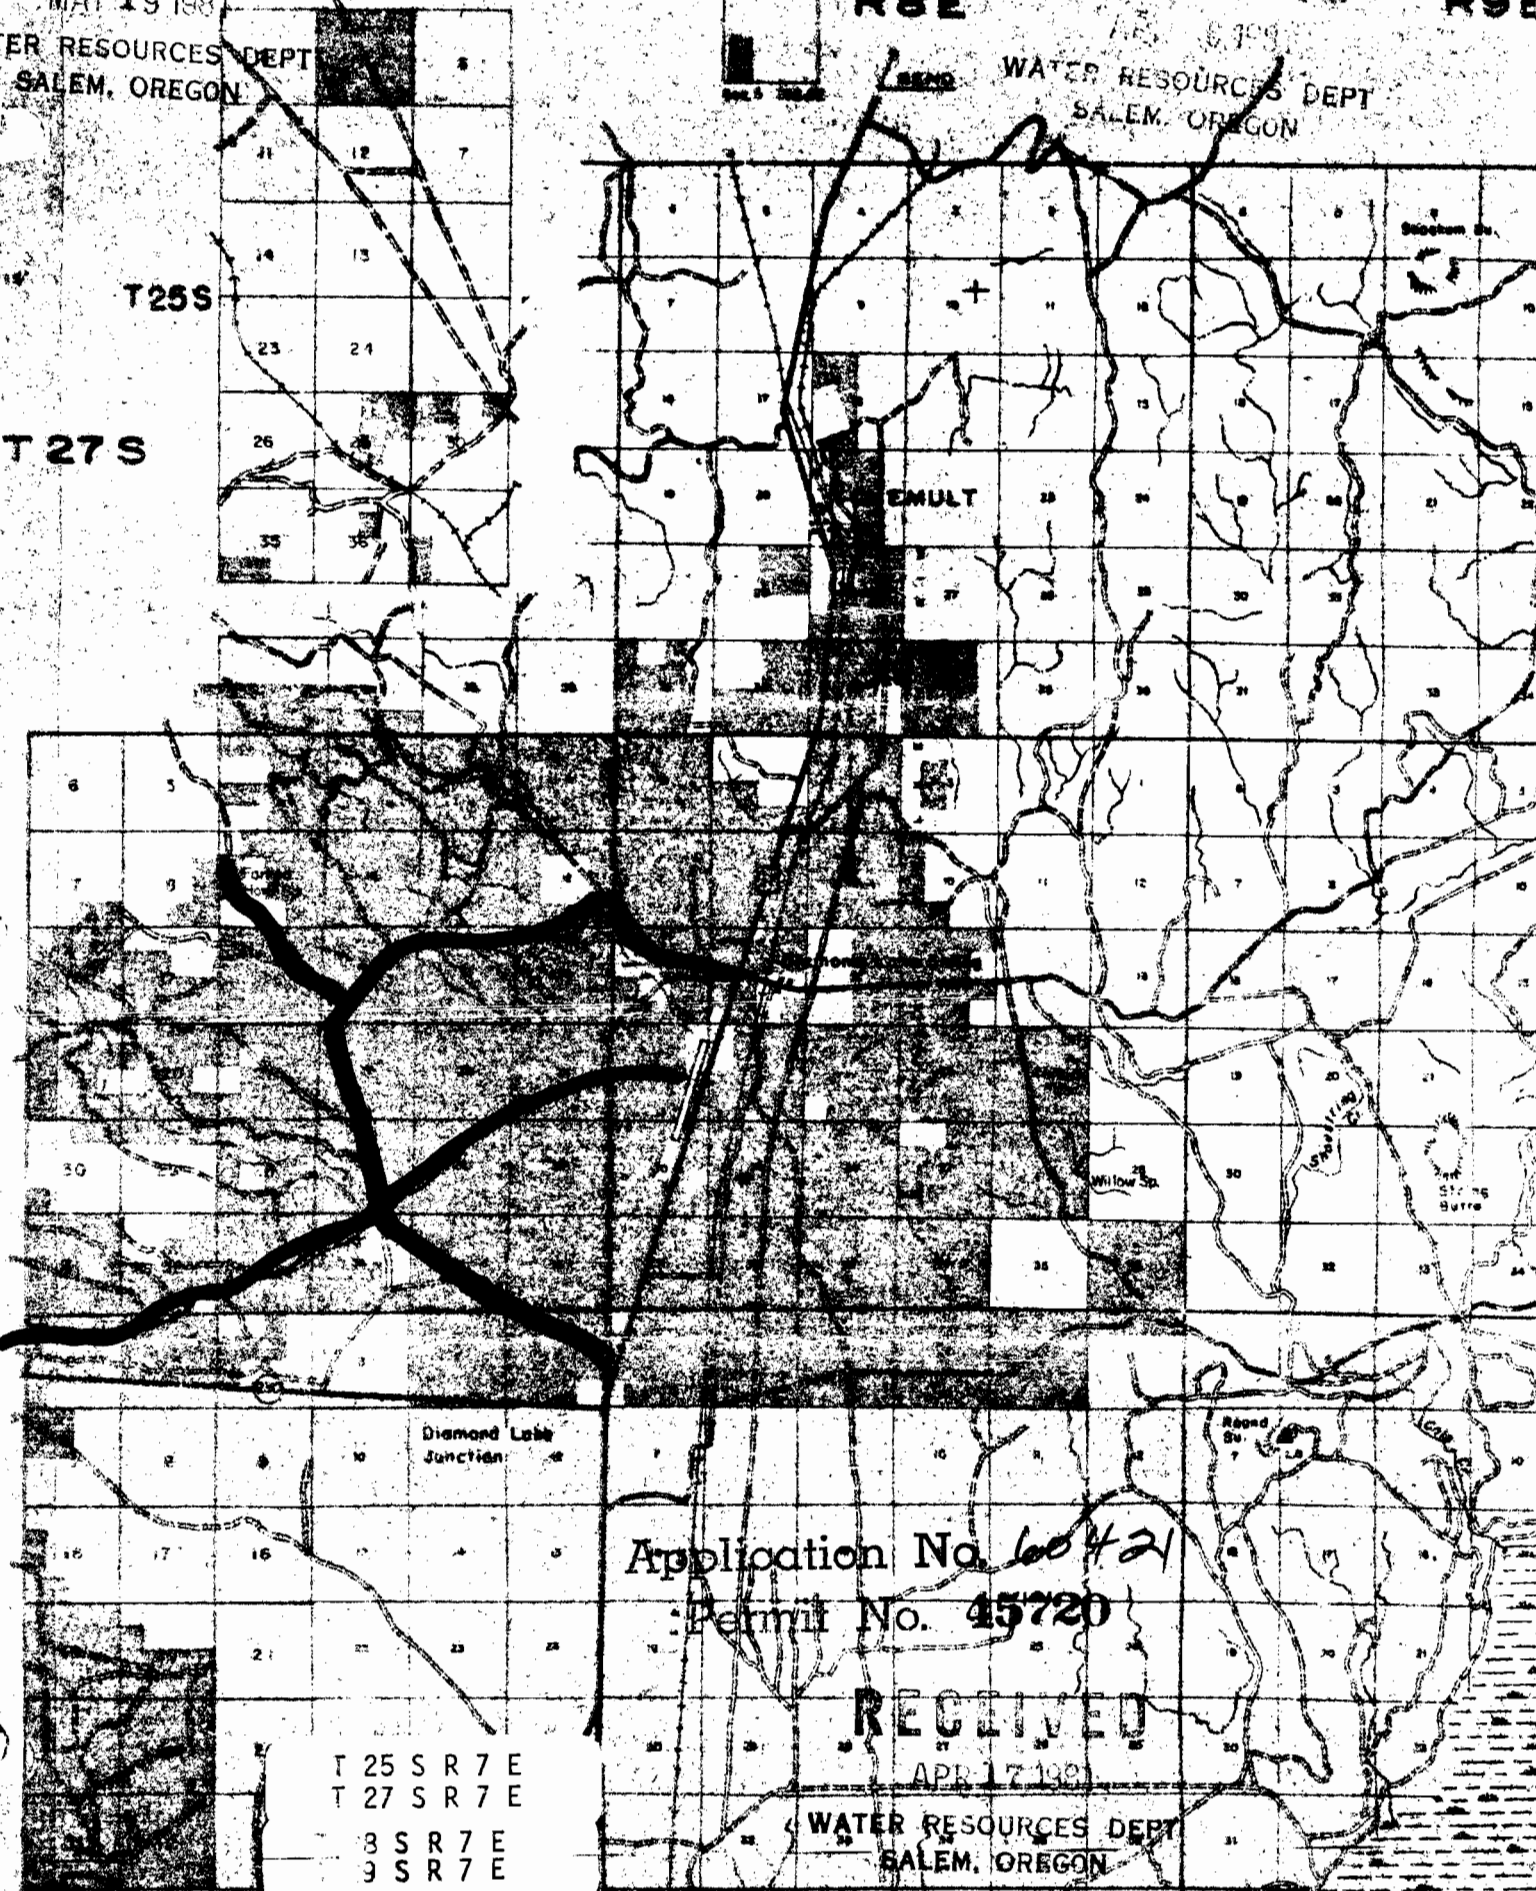

Application No. 600421

Permit No. 45720

RECEIVED

APR 17 1981

WATER RESOURCES DEPT
SALEM, OREGON

T 25 S R 7 E
 T 27 S R 7 E
 8 S R 7 E
 9 S R 7 E