


T. 35 S., R. 1 W., W. M.

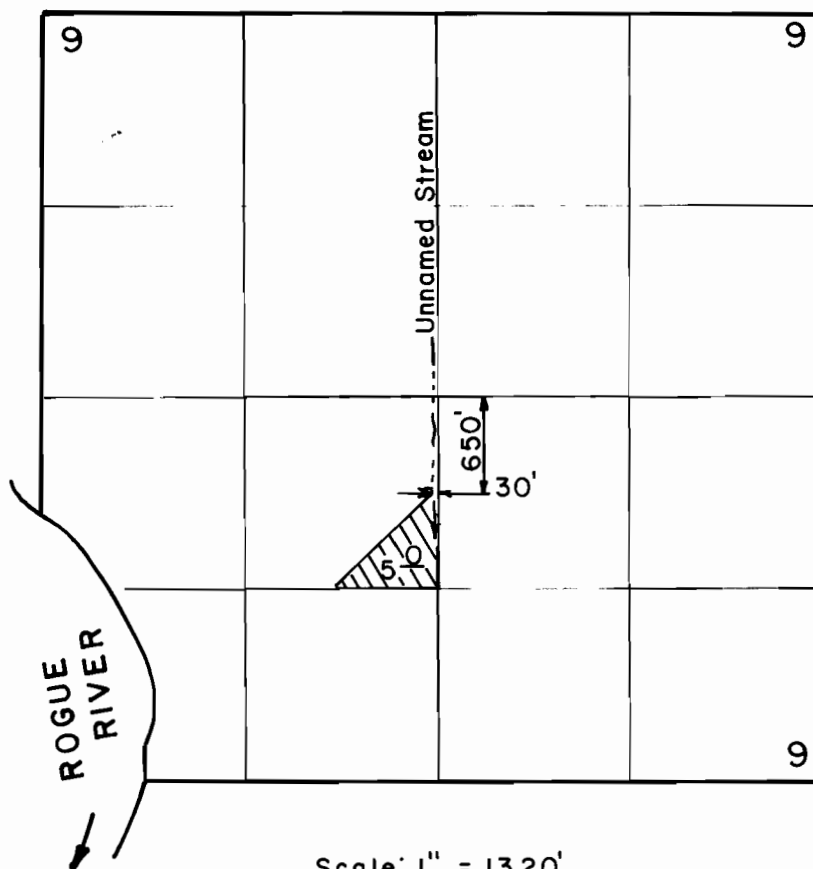

**FINAL PROOF SURVEY
UNDER**

Application No. 60272 Permit No. 45842...
IN NAME OF

.....JOHNNY.....MILLARD.....

Surveyed JUNE 25, 1991., by L.M. JOACHIMS