


J-5930

RECEIVED
APR 1 1987
WATER RESOURCES DEPT.

T.4S.,R.3W.,W.M.

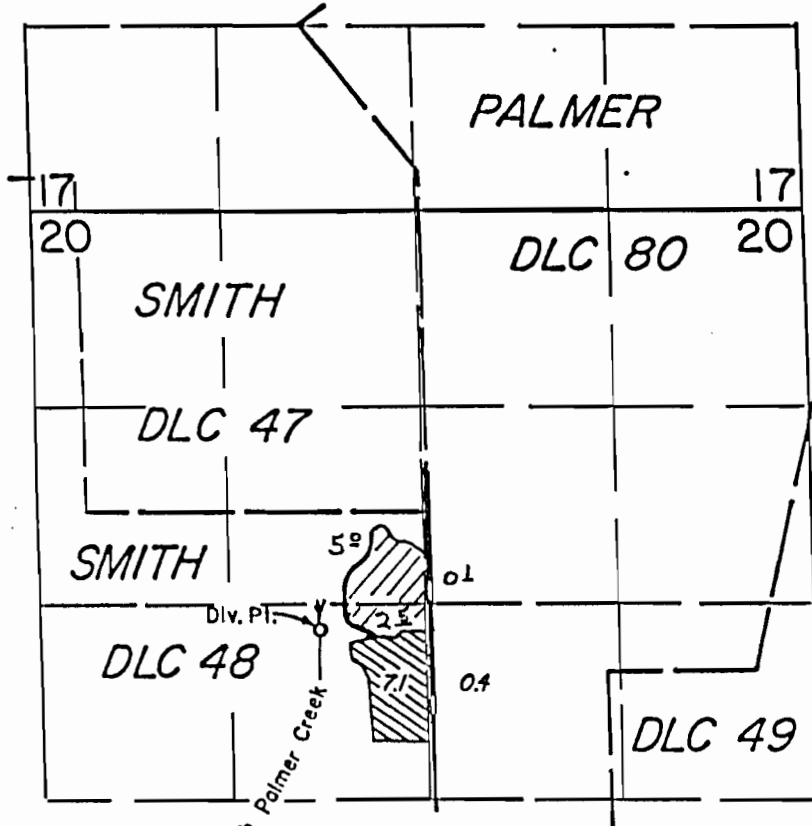

3546