


T.8&9S.R.25E.W.M.

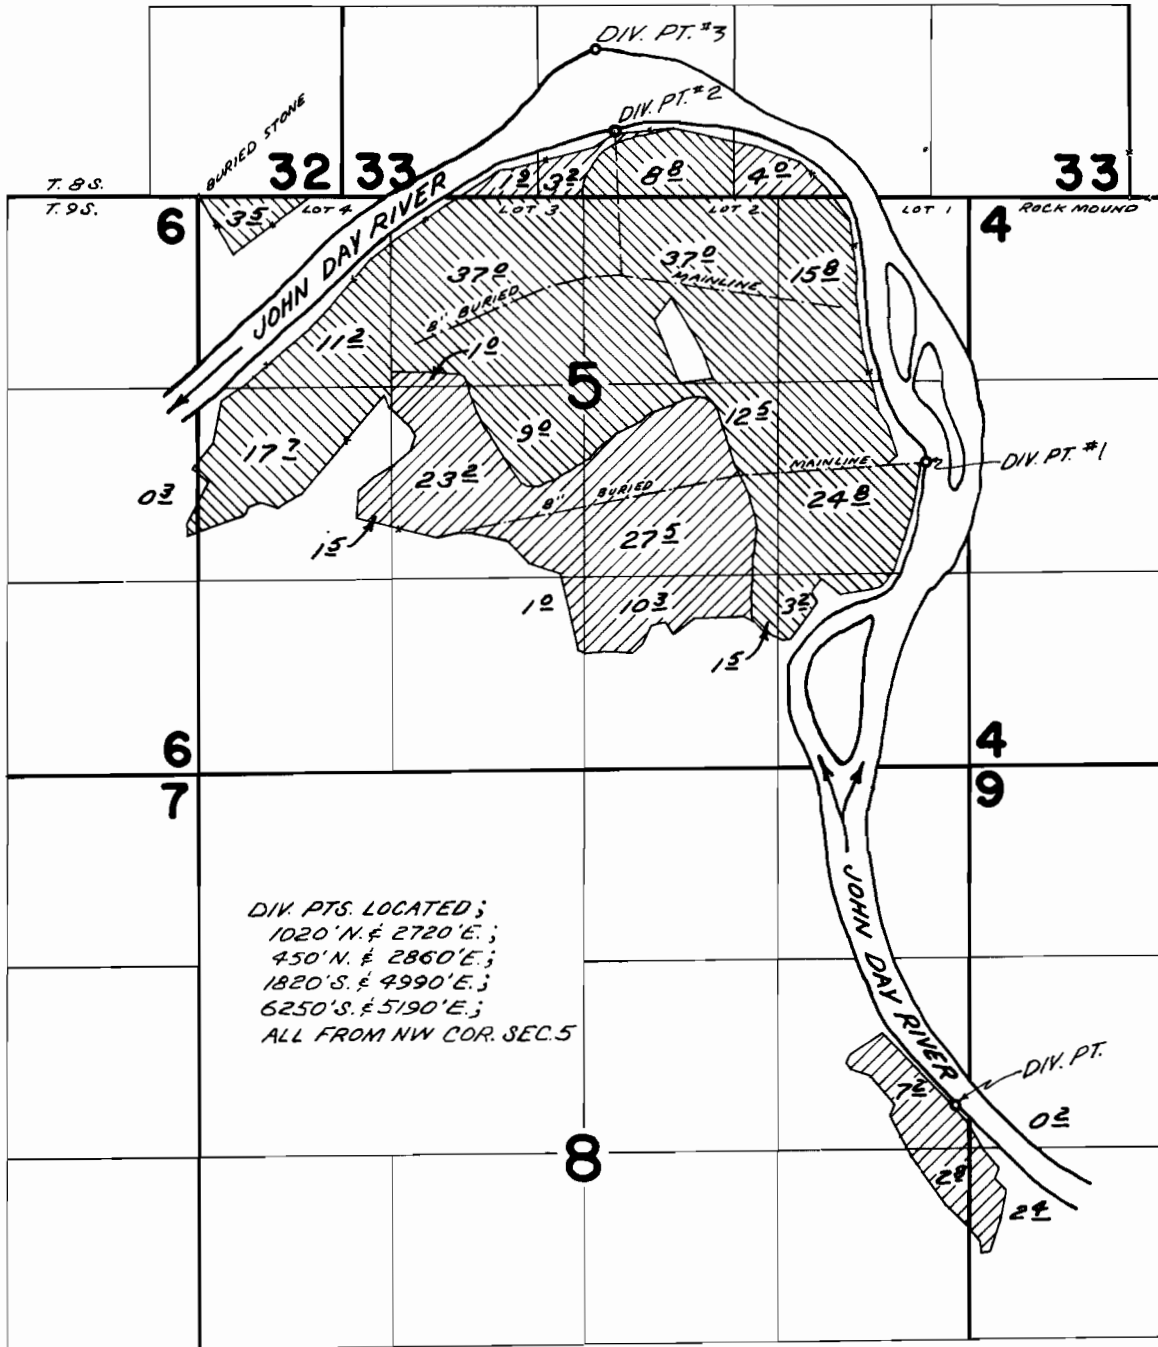

FINAL PROOF SURVEY UNDER

L-100 &
 TRANSFER No. M-165
 Application No. 44149 Permit No. 32864 
 IN NAME OF

ANDREW F. & MAXINE F. LECKIE

Surveyed FEB 9-11 1970, by D. BUELL