


T.8&9S.R.25E.W.M.


RECEIVED

JUN 19 1987
 WATER RESOURCES DEP
 SALEM, OREGON

T-5961

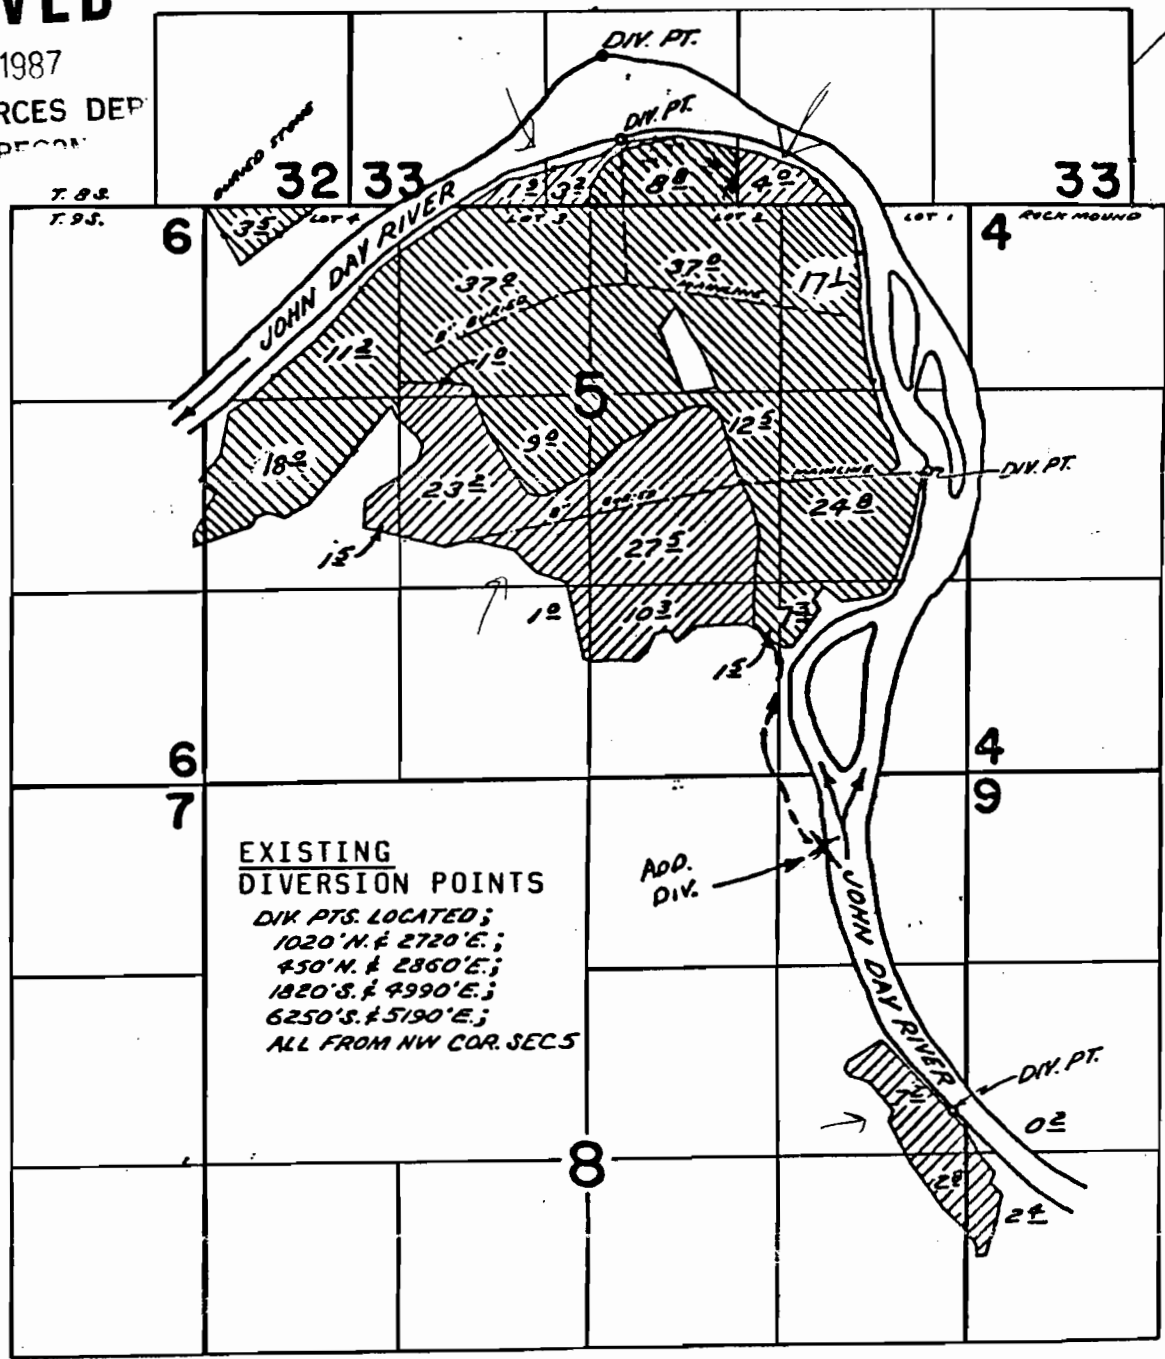

Certificate 52096 & 52098
 Certificate 36654

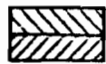

ADDITIONAL DIVERSION POINT LOCATION; 500'S & 1000'W from NE cor. Sec. 8