


T. 6 N., R 35 E., W.M.

RECEIVED
APR 12 2000
WATER RESOURCES DEPT.
SALEM, OREGON

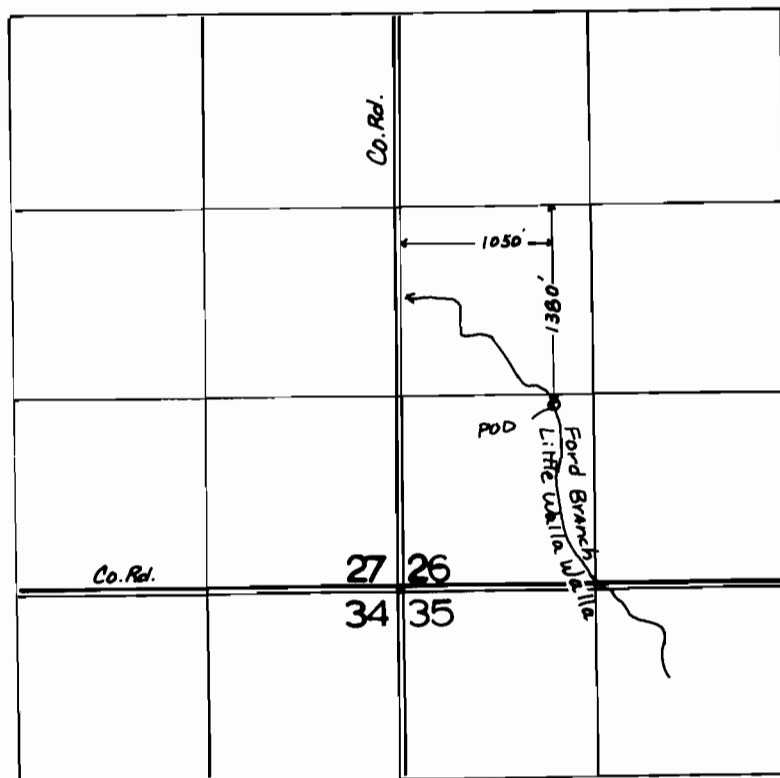

FINAL PROOF SURVEY
UNDER

TRANSFER NO. 5764

Application No. Permit No.
IN NAME OF

..... DANIEL LEFORE

Surveyed 10.-19.... 2000., by ... J. MILLER