


T.18S.,R.45E.,W.M.

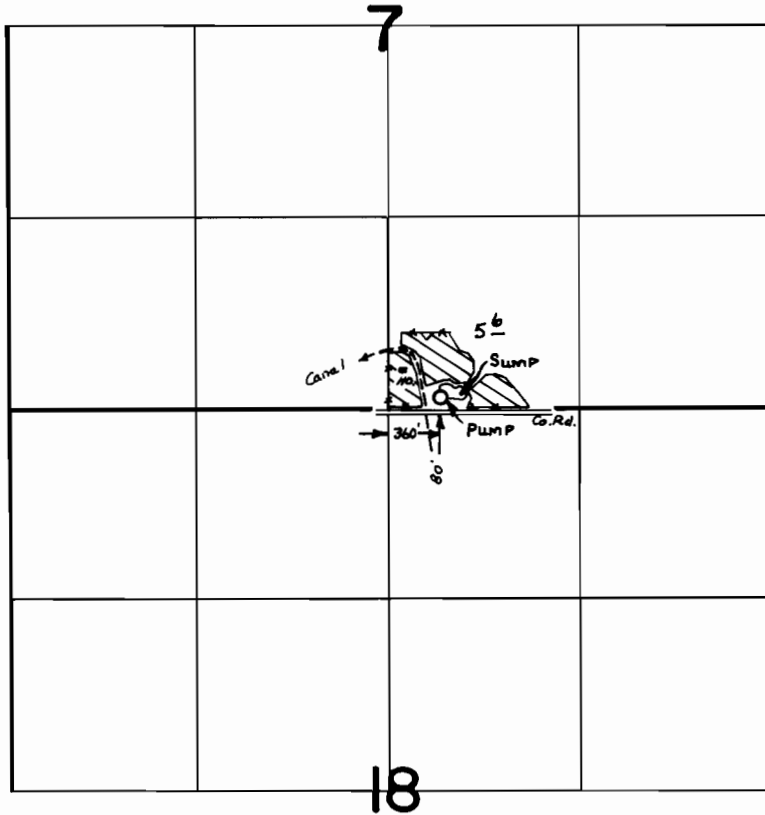

**FINAL PROOF SURVEY**  
UNDER

Application No. ..G:9697. Permit No. ..G:9197.....  
IN NAME OF

.....**JAKE W. ELFERING**.....

Surveyed Aug.....19... 19.83, by ..L.M.TOLL.....