


Township 8 South, Range 25 East, W.M.

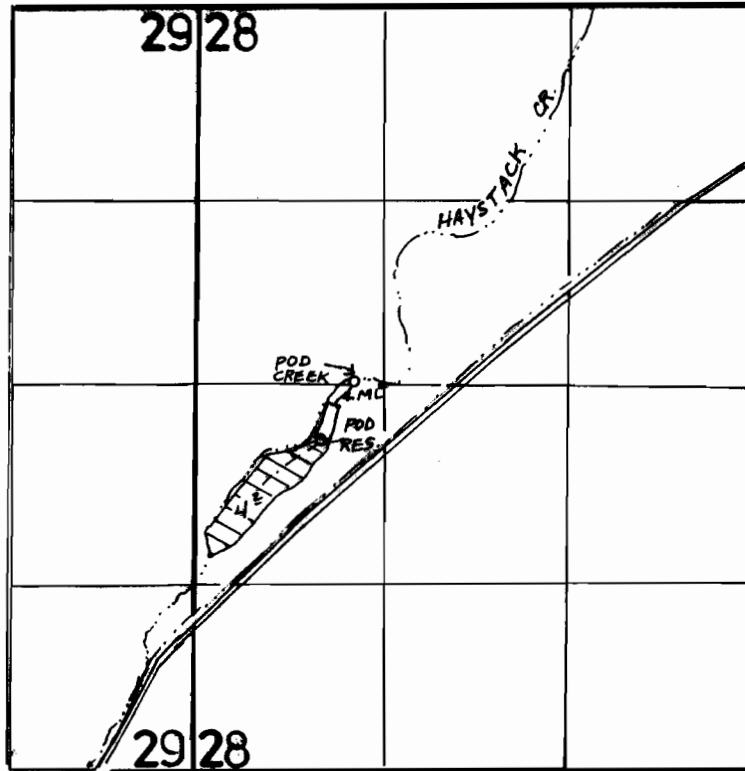

1" = 1320'

CREEK POD - 20' N. & 1100' E. }
RES. POD - 370' S. & 870' E. } BOTH FROM THE W 1/4
COR. SEC. 28.

FINAL PROOF SURVEY
UNDER

R-69098 R-10834
Application No. ...62146 Permit No.50044...
IN NAME OF

.....CLARENCE ASHER.....

Surveyed 7-18..... 2000, by J. MILLER.....