


RECEIVED

APR 2 2001

WATER RESOURCES DE-
SALEM, OREGON

T 6 S., R 20 E., W.M.

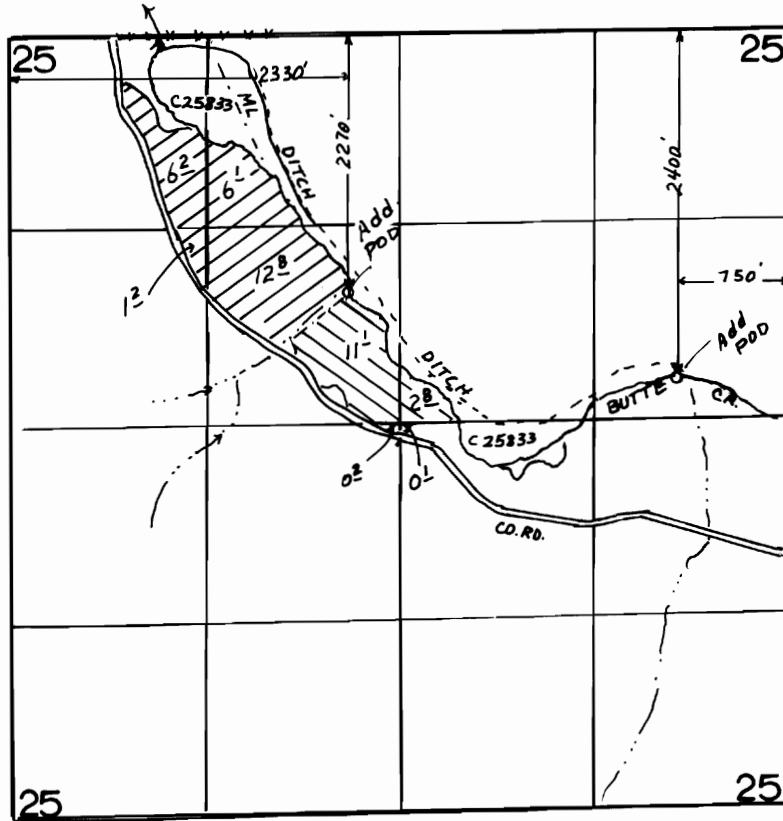

1"=1320'

 PRIMARY
 SUPPLEMENTAL

FINAL PROOF SURVEY UNDER

TRANSFER NO. 3633

Application No. .554.76. Permit No. 42.710.....
IN NAME OF

PHILIP S. & DOUGLAS E. WILSON

Surveyed .6-5..... 2000, by J.MILLER.....