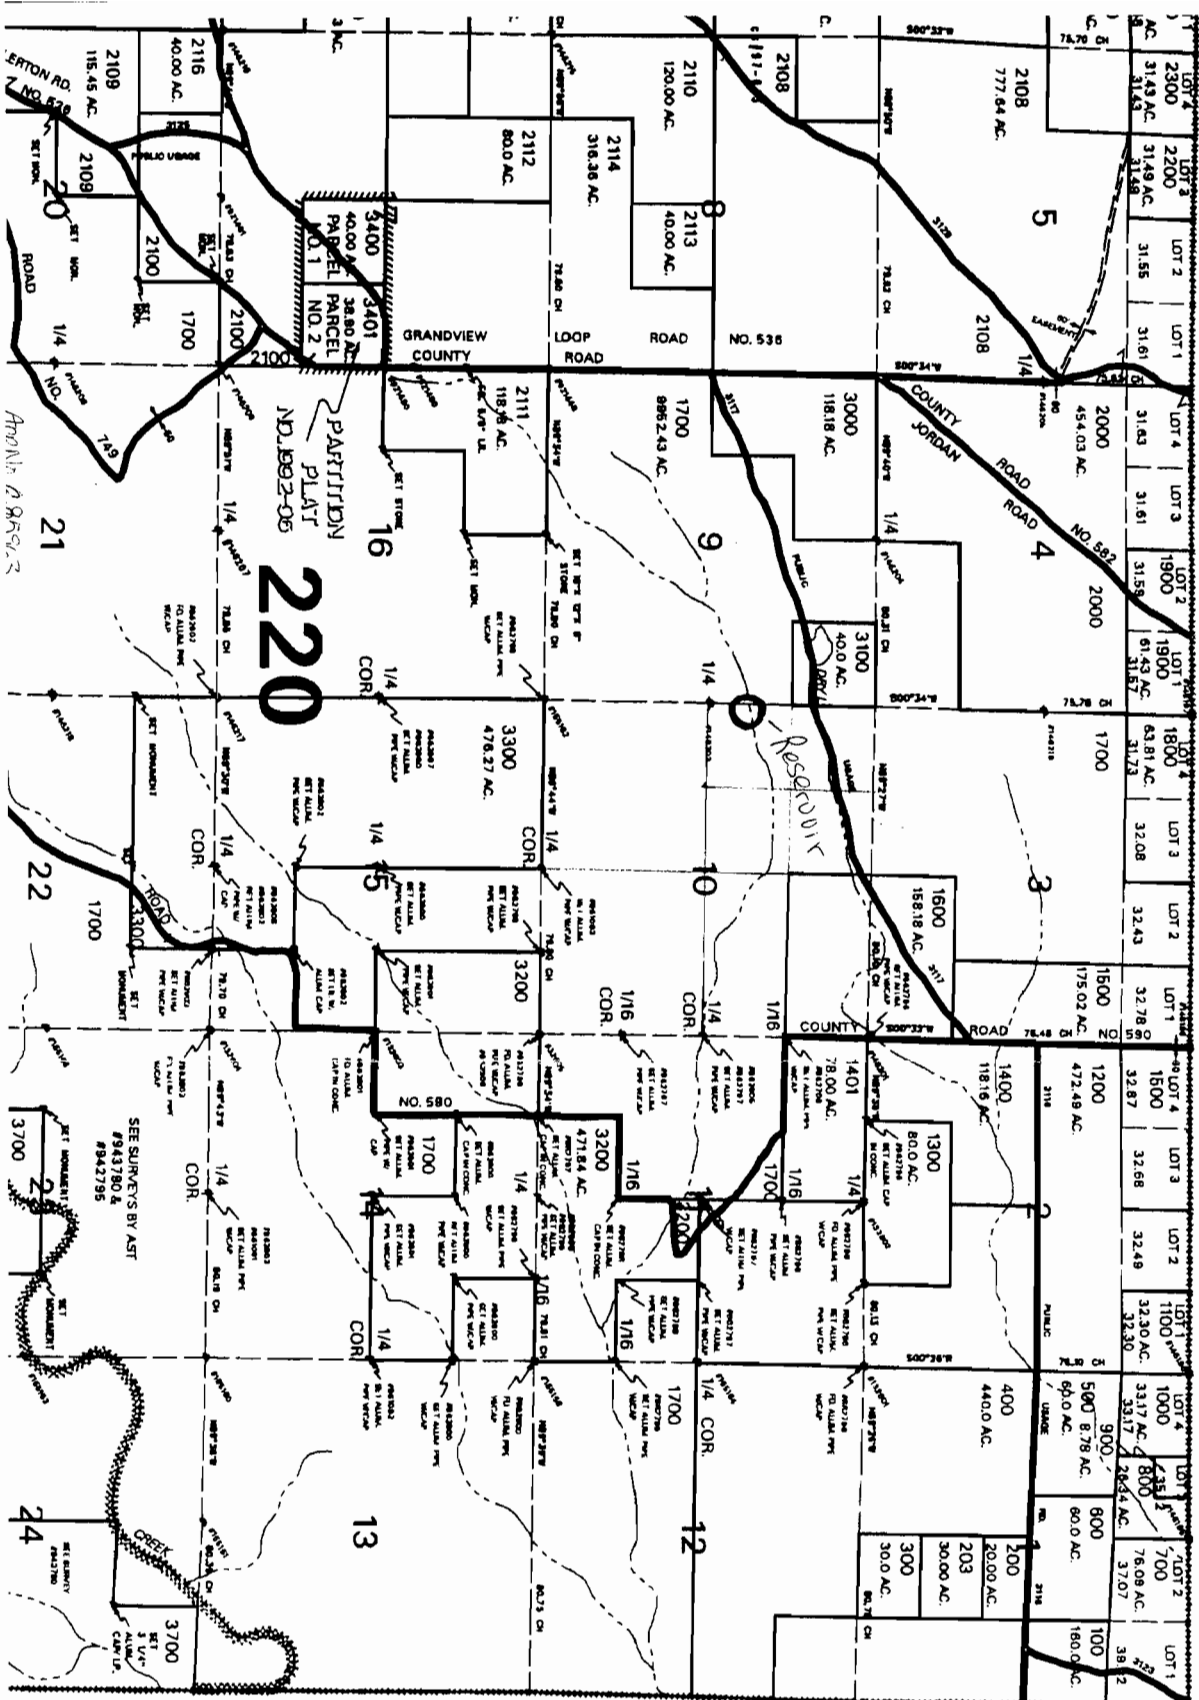


JEFFERSON COUNTY

SEE MAP 12 11

SECTIONS	3, 4, 9, 10	
2000	ft SOUTH	
300	ft EAST	

13 11
& INDEX

CANCELLED NO.

- | |
|------|
| 3800 |
| 201 |
| 202 |
| 4003 |
| 4005 |
| 2101 |
| 2102 |
| 2103 |
| 2104 |
| 2105 |
| 2106 |
| 2107 |
| 4001 |
| 4002 |
| 4004 |
| 4006 |
| 4007 |
| 4011 |
| 4101 |
| 4102 |
| 4200 |

Lat. 44°27.646'
Long. 121°24.748'
NAD 1983

SEE MAP 13 12