


# T. 10S., R. 30E., W. M.

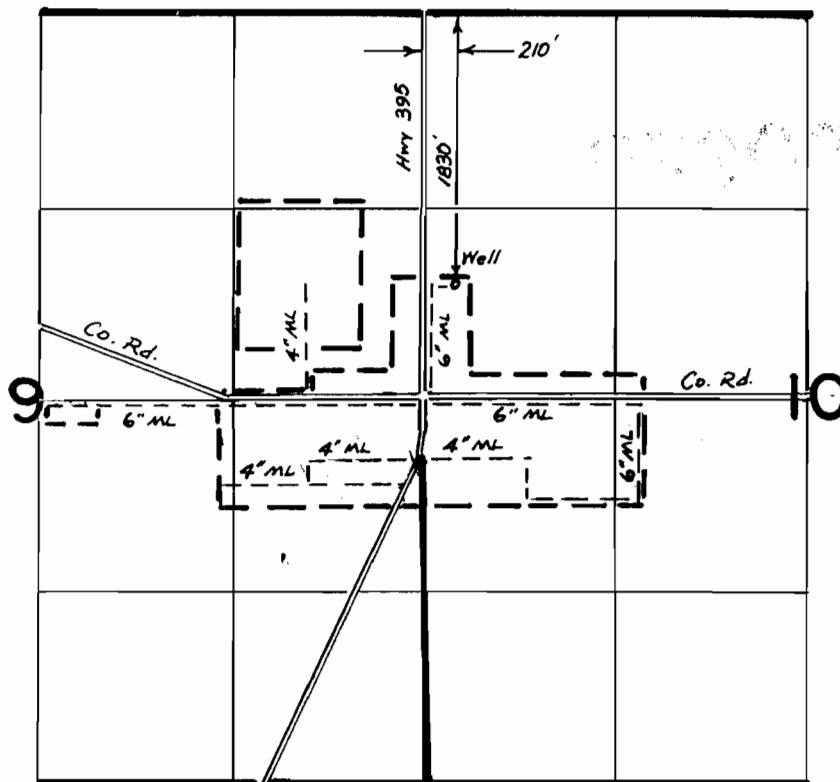

## FINAL PROOF SURVEY UNDER

Scale 1" = 1320'

Application No. G8985 Permit No. G8398....  
IN NAME OF

.....CITY OF LONG CREEK.....

Surveyed 8-22 1990, by K. Kemp.....