


[illegible]

41069-179-244R JM 3-7-95

T. 11 & 12 S., R. 20 E., W.M.

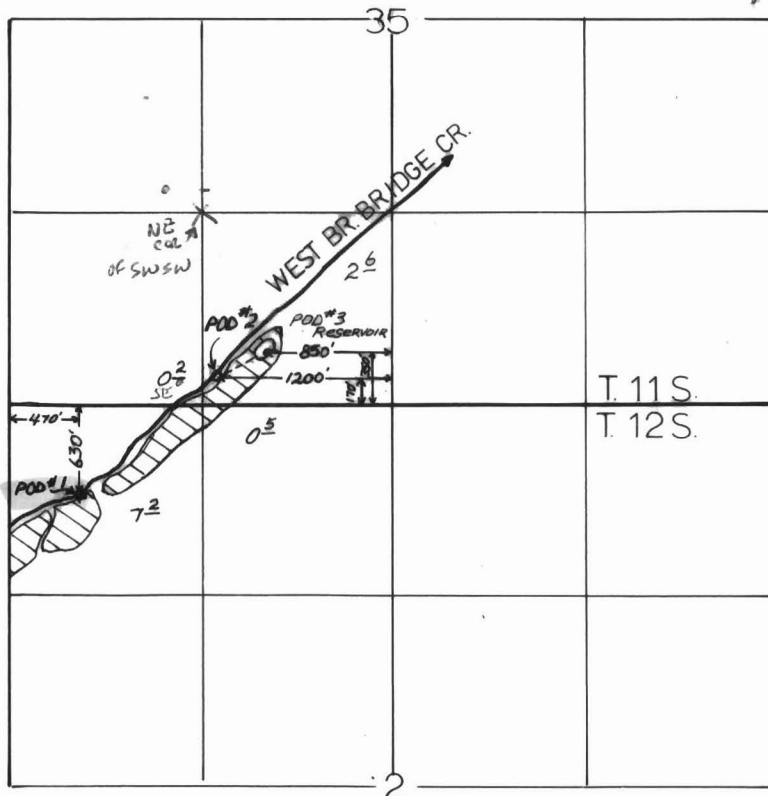

POB for SW = 1 + 3

1 = creek 3 = Res.

POB #2 = for RES TO fill ONLY.

#1 - 630' S, 470' E
FROM NW COR
SEC 2 T12S

#3 350' N + 850' W
FROM S COR SEC 35
T 11S

FINAL PROOF SURVEY

UNDER

Application No. R-61971 Permit No. R-8365
IN NAME OF 46481

MICHAEL PATRICK CARROLL

Surveyed 9-10, 1992, by J. MILLER

Reo POB = 170' N + 1260' W from S COR SEC 35
T 11S R 20E