


T. 1 N., R. 20 E., W.M.

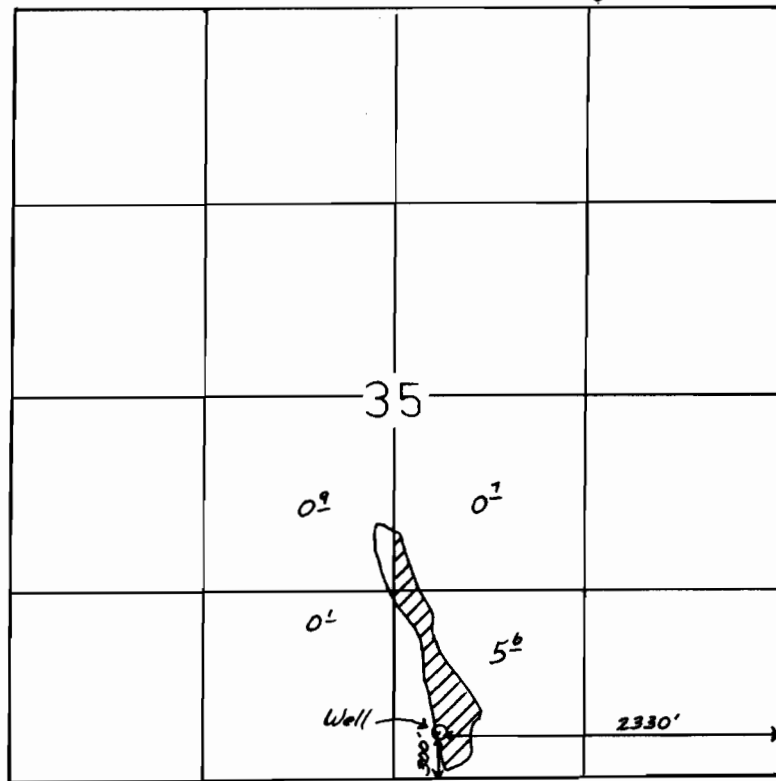

1" = 1320'

FINAL PROOF SURVEY

UNDER

Application No. G-6690 Permit No. G-6238
IN NAME OF

Surveyed 2-6, 1991, by K.KEMP