


T. 2 S., R. 27 E., W.M.

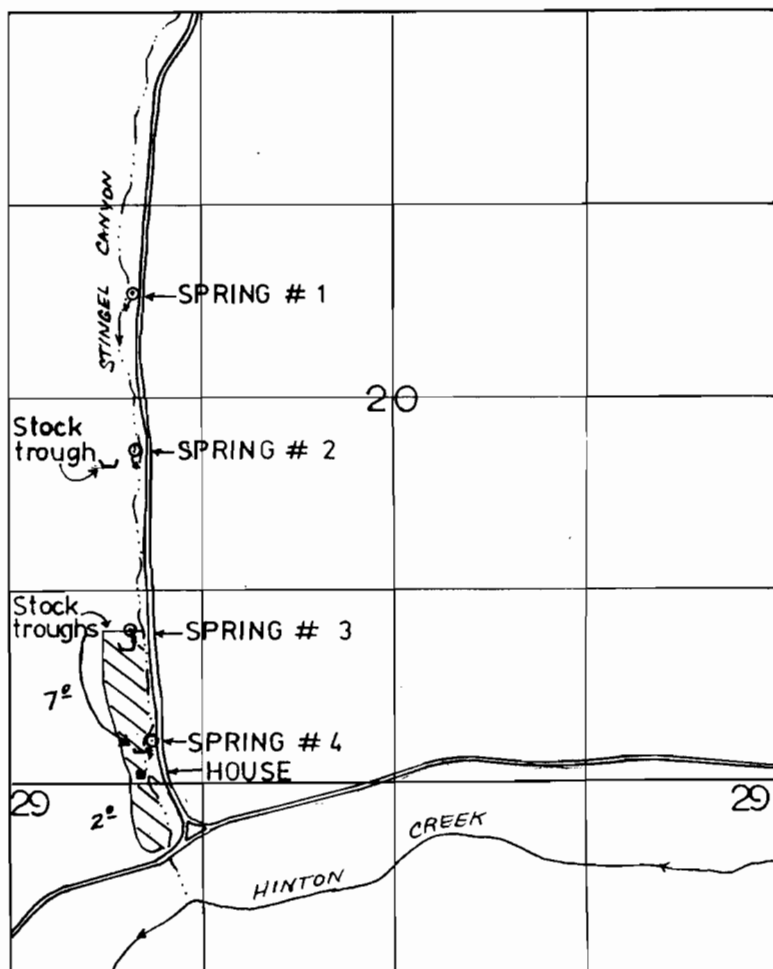

SPRING # 1 - 3370' N. & 820' E.
SPRING # 2 - 2310' N. & 860' E.
SPRING # 3 - 1050' N. & 840' E.
SPRING # 4 - 360' N. & 990' E.
ALL BEING FROM THE SW COR. SEC. 20.

FINAL PROOF SURVEY

UNDER

Application No. 61663 Permit No. 46223
IN NAME OF

GORDON E. CRABER

Surveyed 9-8, 1993, by J. MILLER