


T. 11 S., R. 20 E., W. M.

RECEIVED

MAY - 2 1937

WATER RESOURCES DEPT.
SALAM, OREGON

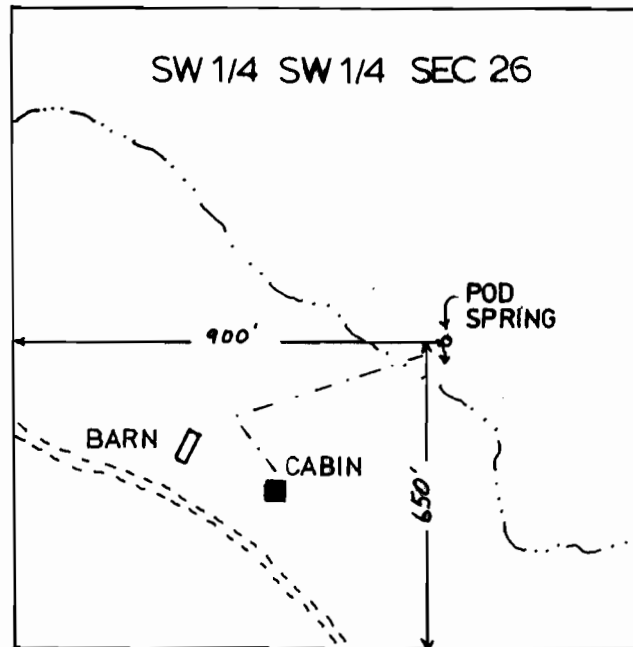

N

1" = 400'

FINAL PROOF SURVEY UNDER

Application No. 48424.... Permit No. 42648.....

IN NAME OF

Douglas E. Kopsa, Virginia Kopsa, Robert A.
.....And Betty J. Stott.....

Surveyed Oct. 4... 1994, by J. Miller.....