


T. 8 S., R 22 E., W. M.

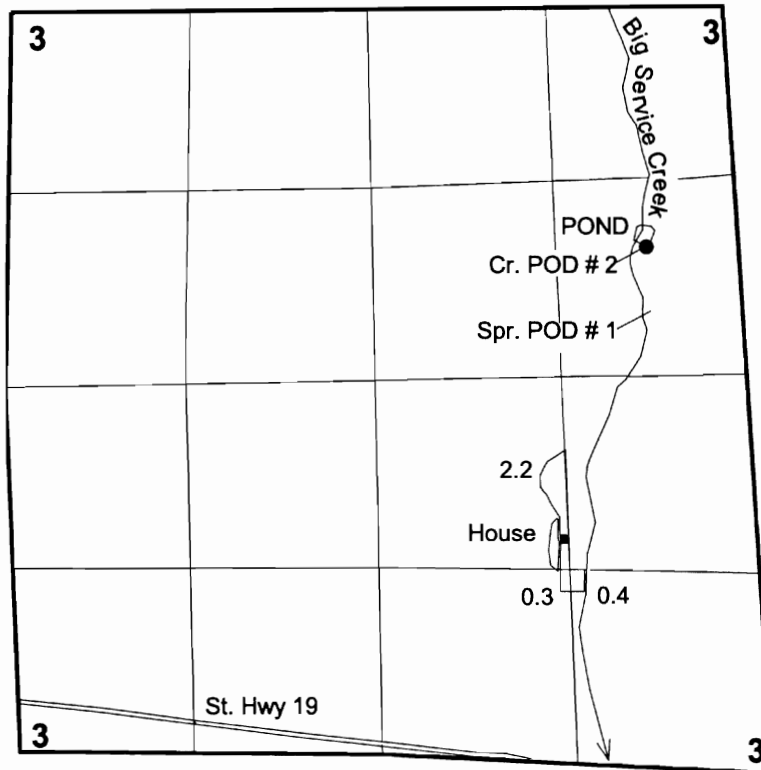

Spring, POD # 1 - 459 feet North and 573 feet west.
Creek, POD # 2 - 890 feet North and 650 feet West.
Both from the East 1/4 Corner of Section 3.

FINAL PROOF SURVEY UNDER

Transfer No. 4762

Application No. 61626, Permit No. 45864

IN THE NAME OF
ORVAL AND SABINE LADD

Surveyed 5-02-2001, by J. Miller