


T 6 S., R 20 E., W.M.

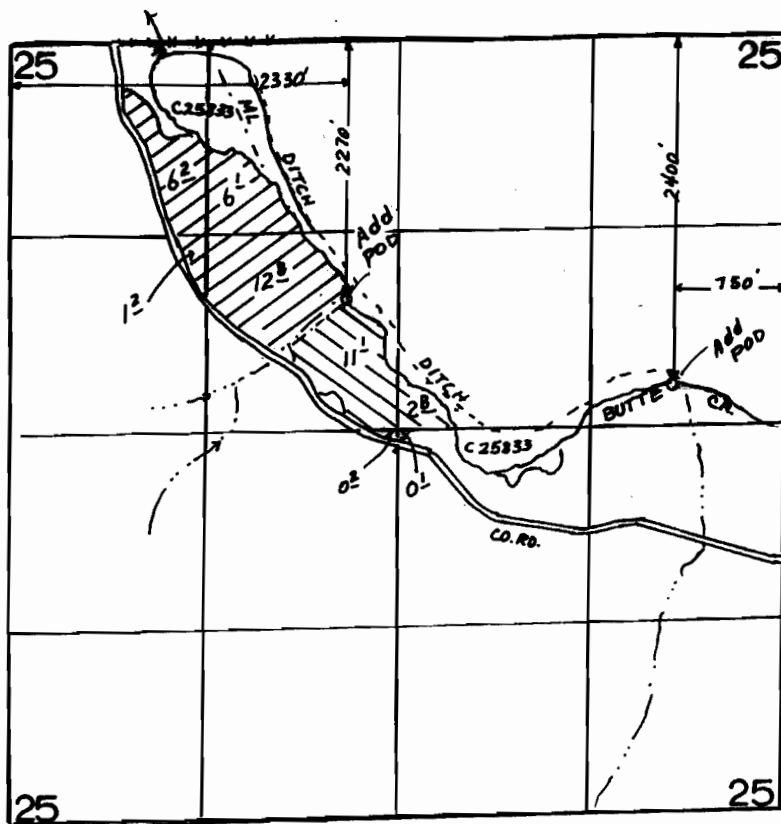

1"=1320'

 PRIMARY
 SUPPLEMENTAL

FINAL PROOF SURVEY UNDER

TRANSFER NO. 3633

Application No. .55476. Permit No. .42.7.10.....
IN NAME OF

..... PHILIP S. & DOUGLAS E. WILSON

Surveyed .6.5..... 2000, by J.MILLER.....

RECEIVED

APR 02 2001

WATER RESOURCES DEPT
SALEM, OREGON