


T. 7 S., R. 1 W., W.M.

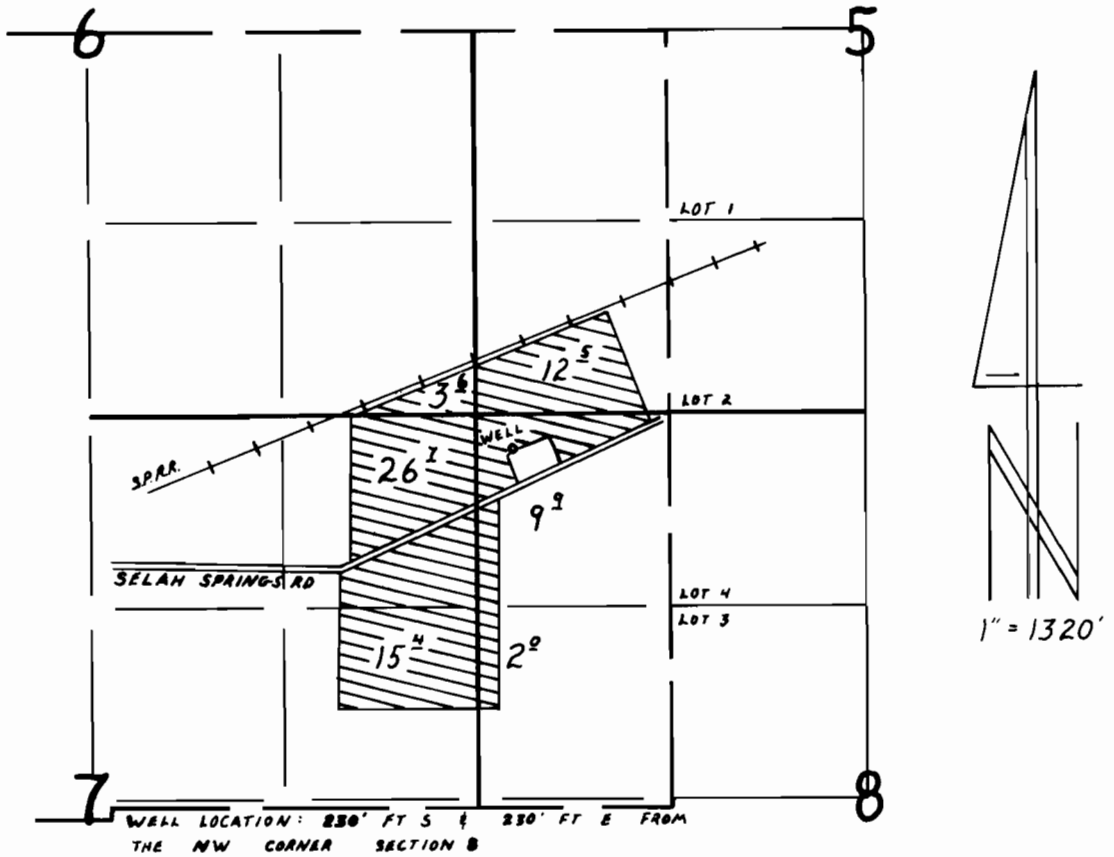

FINAL PROOF SURVEY

UNDER

Application No. G-11629 Permit No. G-10722
IN NAME OF

CLIFFORD HERR

Surveyed MARCH 19, 1991, by R.W. Klassen