


T.19S., R.18E., W.M.

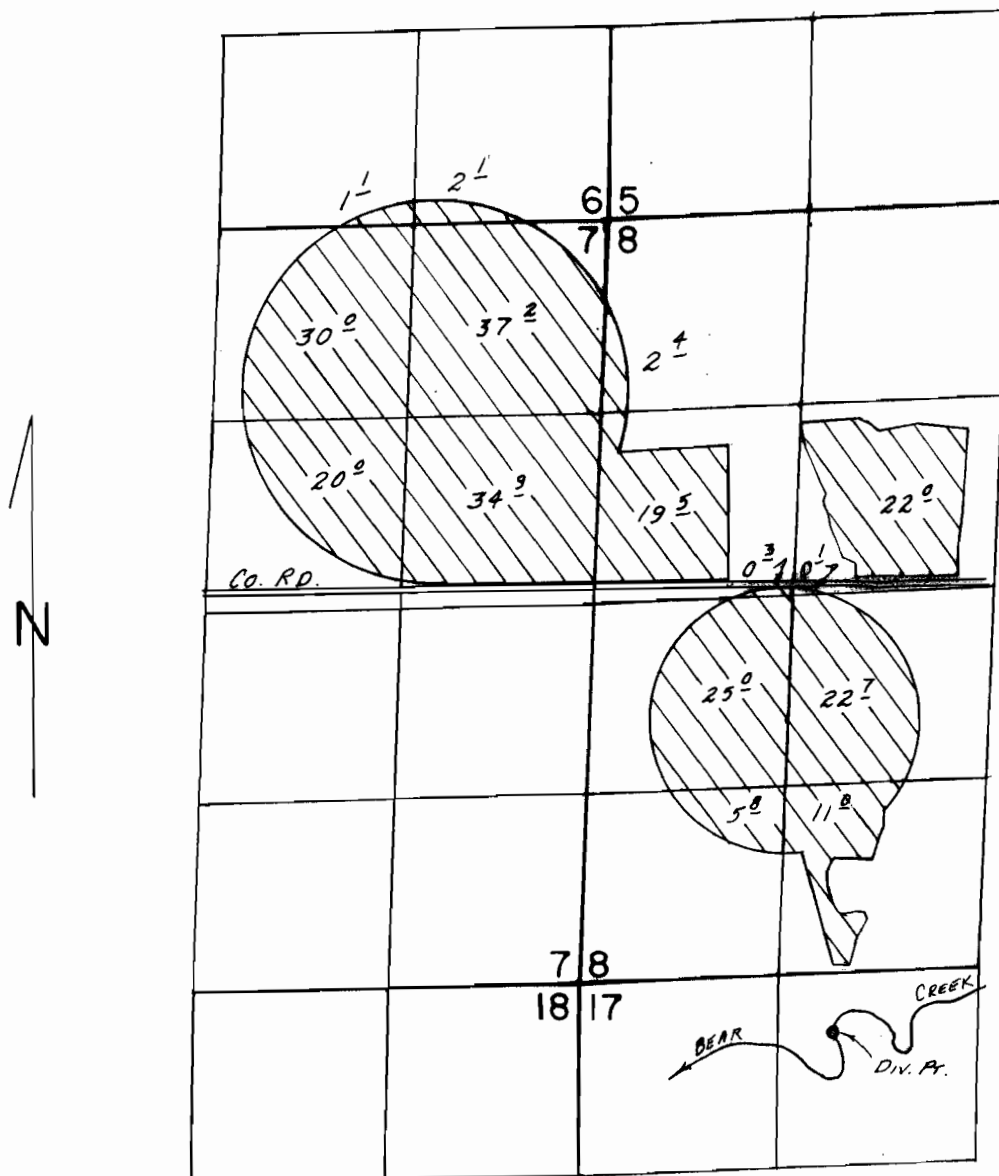

DIV. PT. LOC.: 350'S. & 1730'E. FROM NW COR. SEC. 17.

SCALE: 1"=1320'

FINAL PROOF SURVEY UNDER

Application No. 59695. Permit No. 46501.....
IN NAME OF

.....WILLIAM R. McCORMACK.....

Surveyed Mar. 23. 1990, by B.W. BISHOP....