


T. 9 S., R 23 E., W.M.

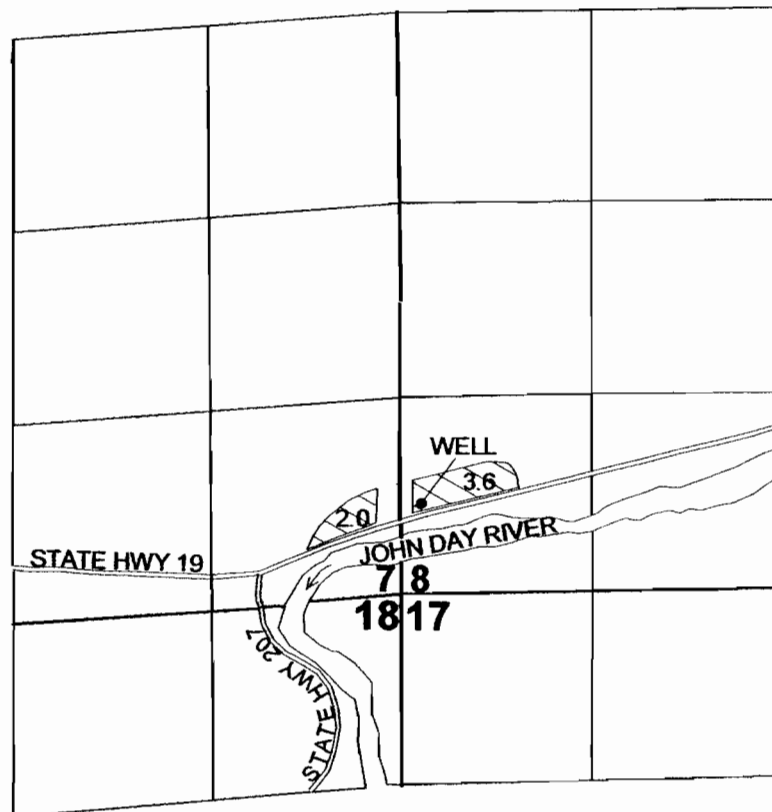

1" = 1320'

WELL - 600' NORTH & 138' EAST FROM THE SOUTHWEST
CORNER OF SECTION 8.

FINAL PROOF SURVEY

UNDER

Application No. G-10803 Permit No. G-9896

IN THE NAME OF

KENNETH AND JUDY NORRIS

Surveyed 6-18-2001 by J. Miller