


T. 7 S., R. 3 W., W.M.

SECTION 30

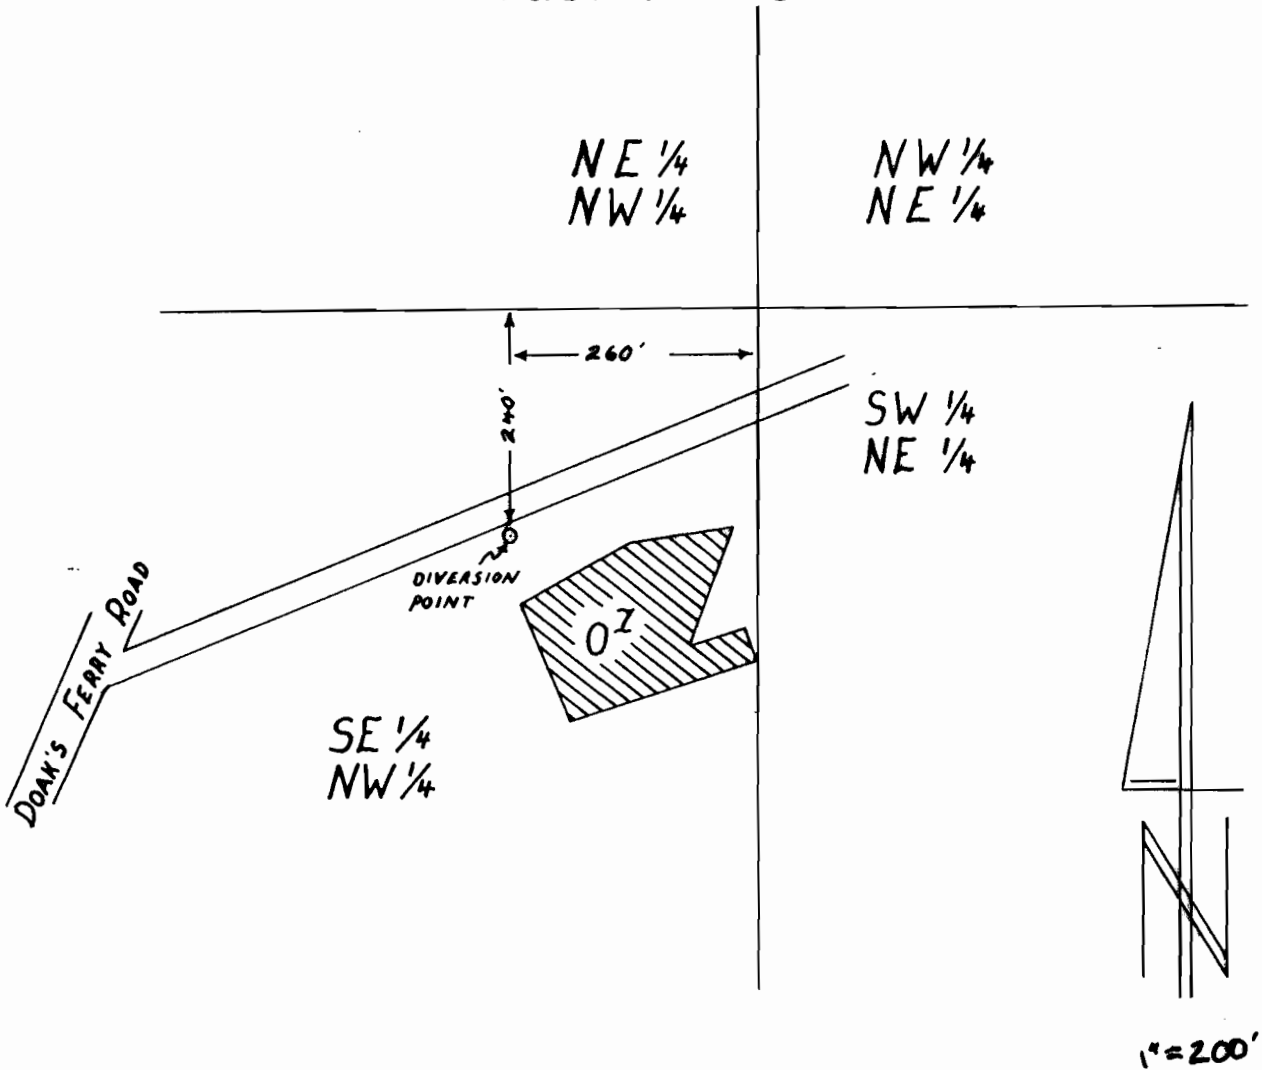

FINAL PROOF SURVEY

UNDER

Application No. 60525 Permit No. 45288
IN NAME OF

DALE B. GILSON

Surveyed OCTOBER 16, 1992, by R.W. Klassen