


T. 9 S., R. 3 E., W.M.

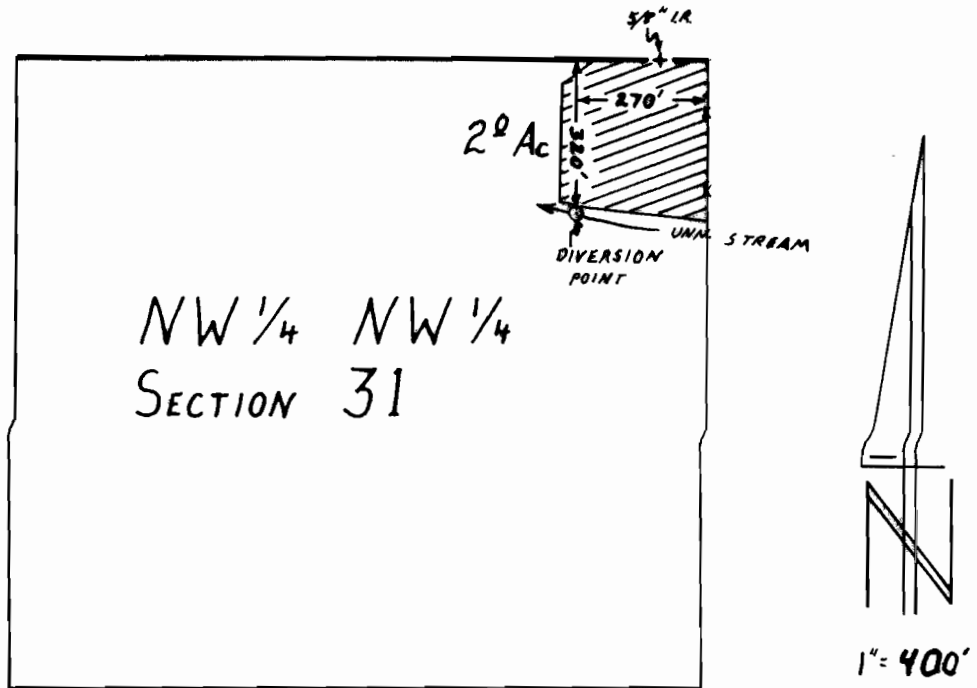

FINAL PROOF SURVEY

UNDER

Application No. 65158 Permit No. 47583
IN NAME OF

VICKI WARD

Surveyed APRIL 12, 1991, by R.W. Klassen