T. 5 & 6 S., R. 1 W., W.M.

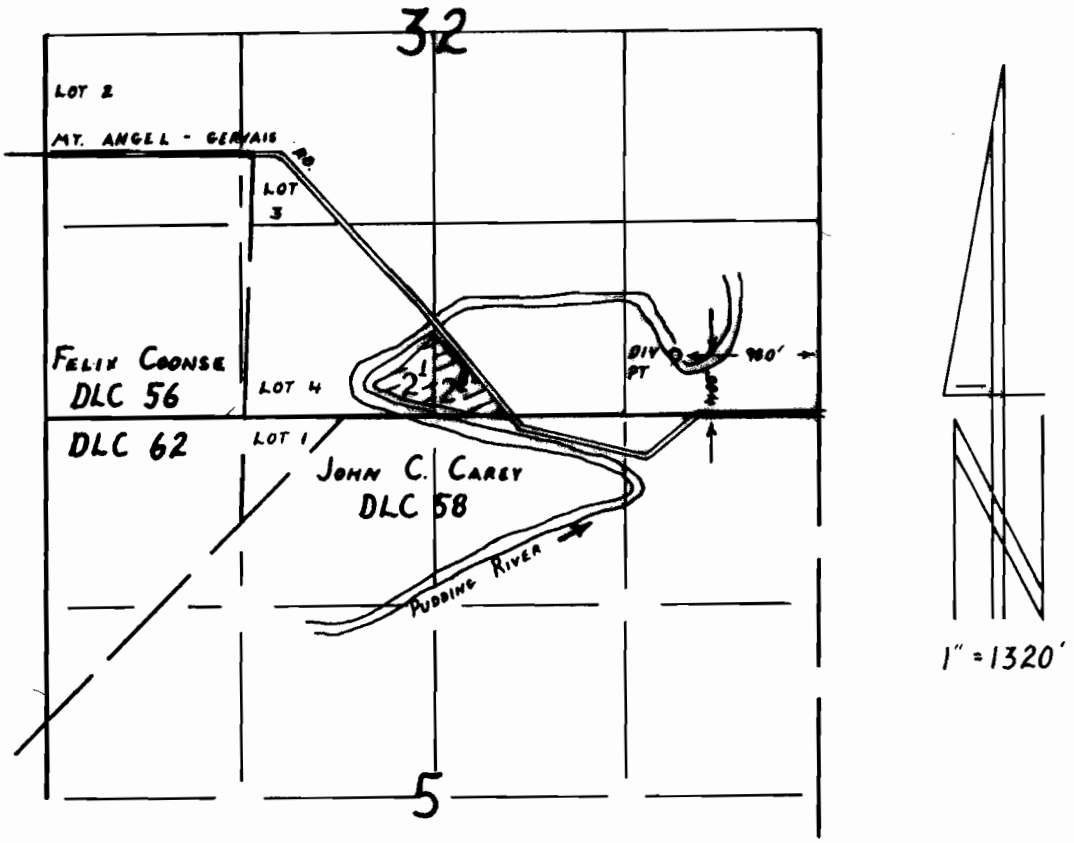

FINAL PROOF SURVEY

UNDER

Application No. 57200 Permit No. 42992

IN NAME OF

RONALD P. VANDECOEVERING

Surveyed AUGUST 14, 1992, by R.W. Klassen

WAC 900R 11-280 RWK 12/92