


T.25 S., R.6 W., W.M.
SECTION 7

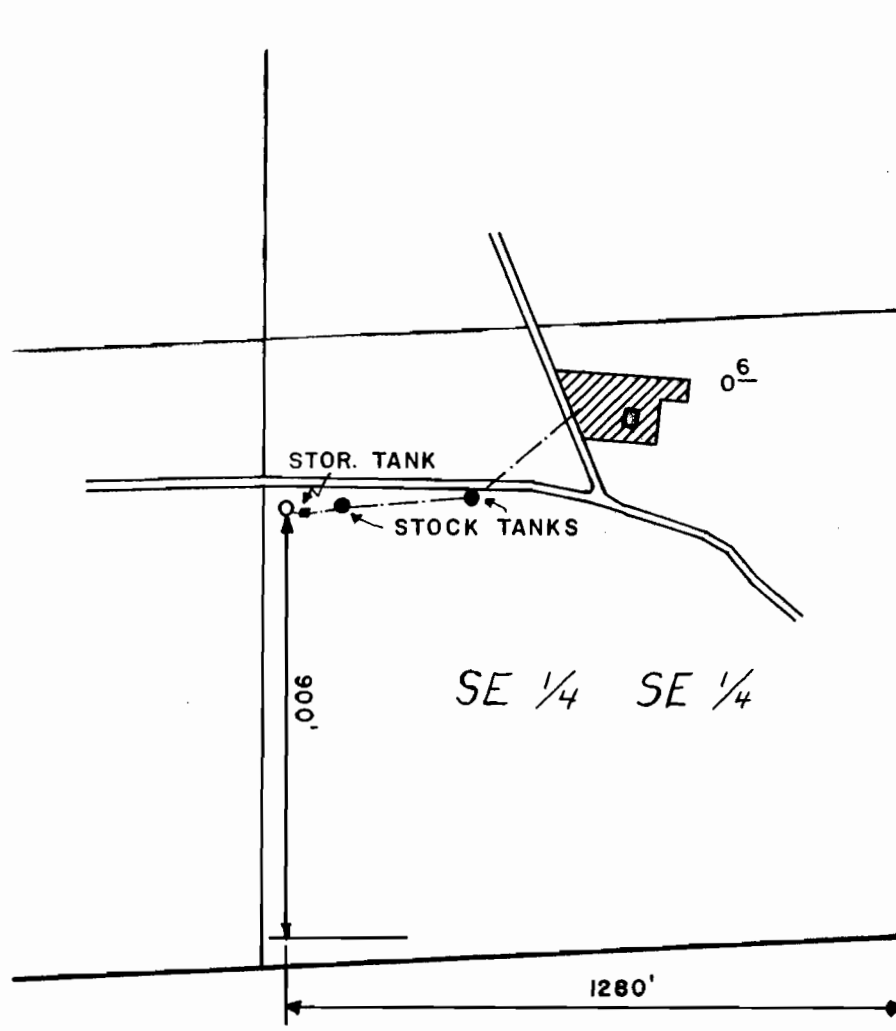

SCALE: 1" = 400'

FINAL PROOF SURVEY
UNDER

Application No. 61596..... Permit No. 45730.....
IN NAME OF

LEROY E. & DOROTHY R. NORTHWAY

Surveyed JULY 9, 1986, by J.M. SCHMORDE