


T.29 S., R.6 W., W.M.

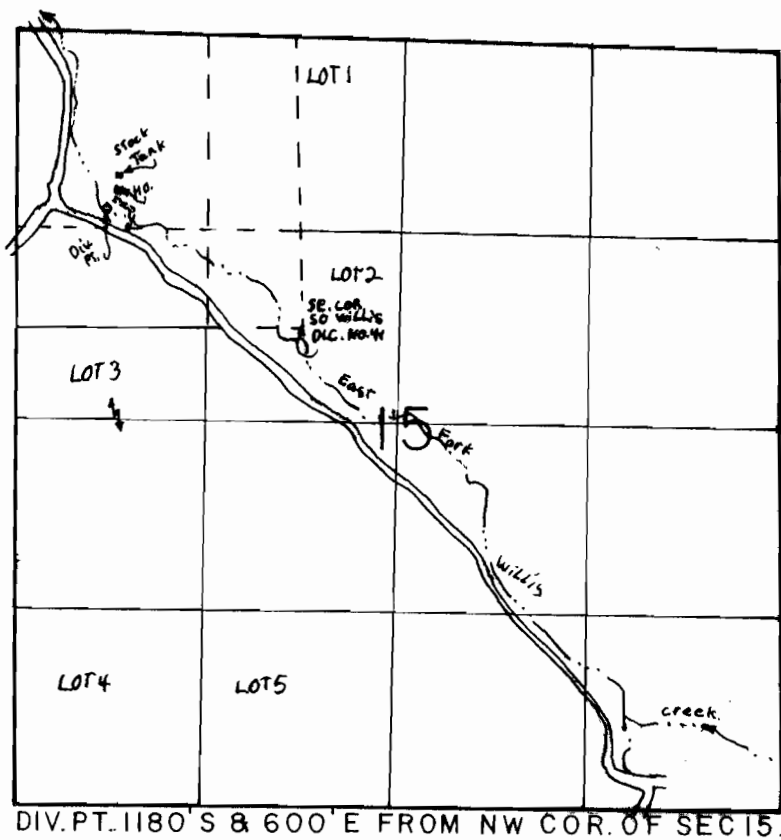

SCALE: 1" = 1320'

**FINAL PROOF SURVEY
UNDER**

**Application No. 62607 Permit No. 47246...
IN NAME OF**

ALVIN E. REESE

Surveyed JUNE 4 19 97, **by** R. M. SUTTERFIELD