T. 9 S., R. 6 W., W.M.

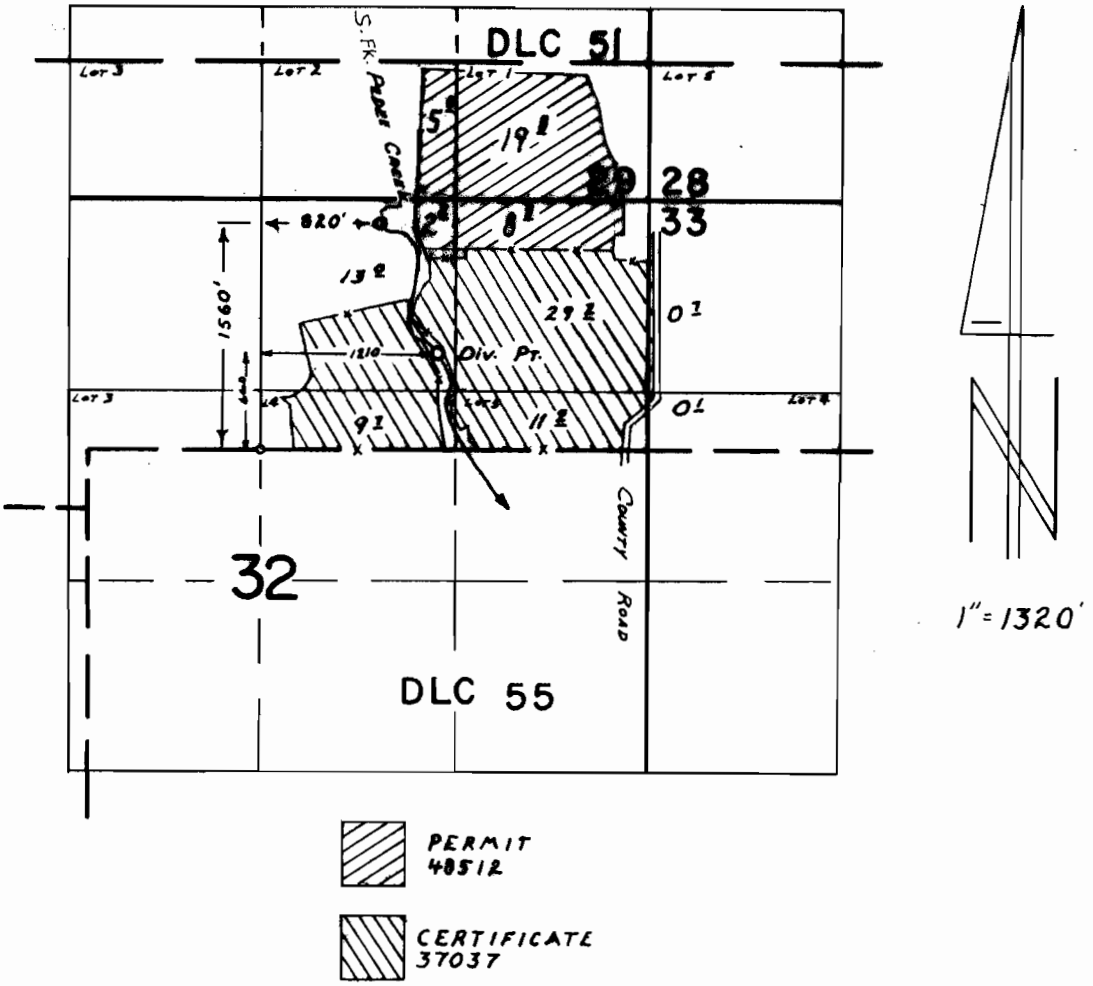

FINAL PROOF SURVEY

UNDER

Application No. 68054 Permit No. 48512

IN NAME OF

Garrett Van Diest, Inc.

Surveyed June 23, 1993, by R.W. Klassen