


T. 3 S., R. 4 & 5 W., W.M.

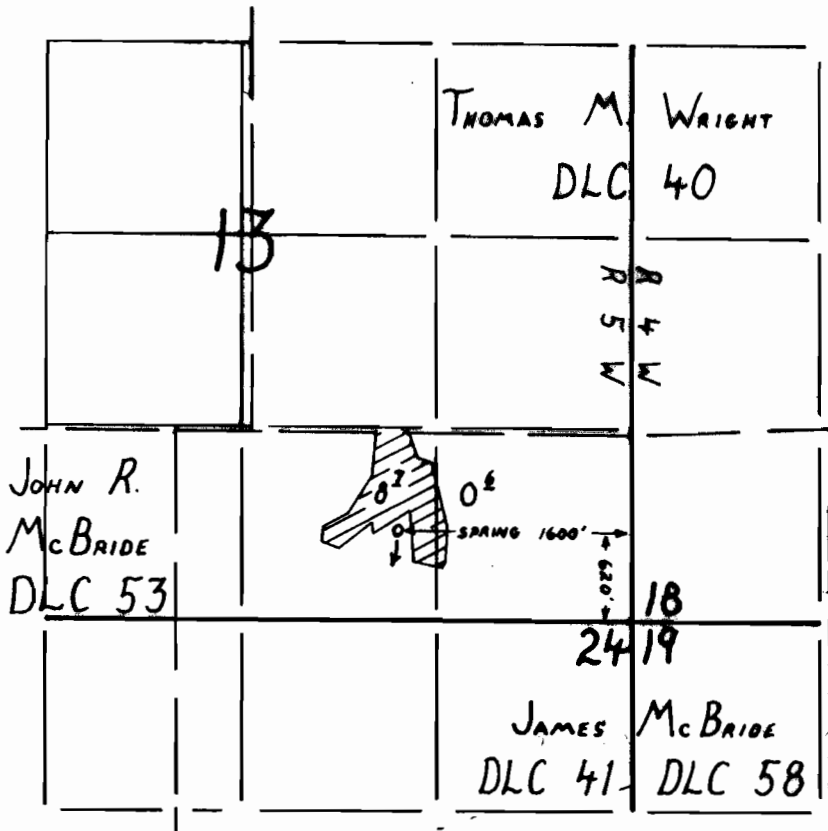

FINAL PROOF SURVEY

UNDER

Application No. 61275 Permit No. 45857

IN NAME OF

ALAN R. RATHMACHER

Surveyed APRIL 28, 1989, by T.M. Warren