


T. 2 N., R. 10 E., W.M.

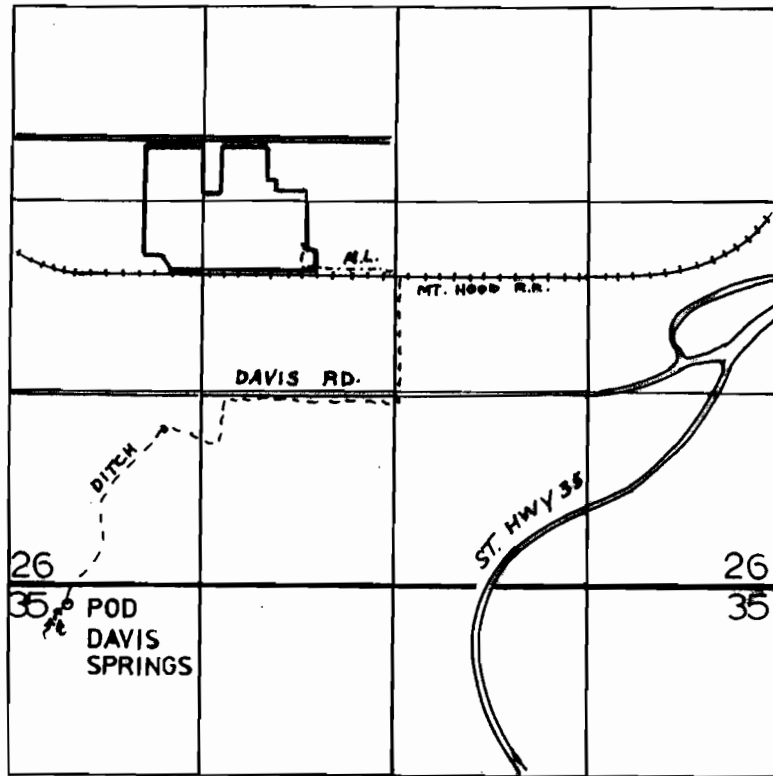

1" = 1320'

POD 70' S. & 420' E. FROM THE NW. COR. OF SEC. 35.

FINAL PROOF SURVEY

UNDER

Transfer 5204

IN NAME OF

DIAMOND FRUIT GROWERS, INC.

Surveyed SEPTEMBER 29, 1993, by I. MILLER