
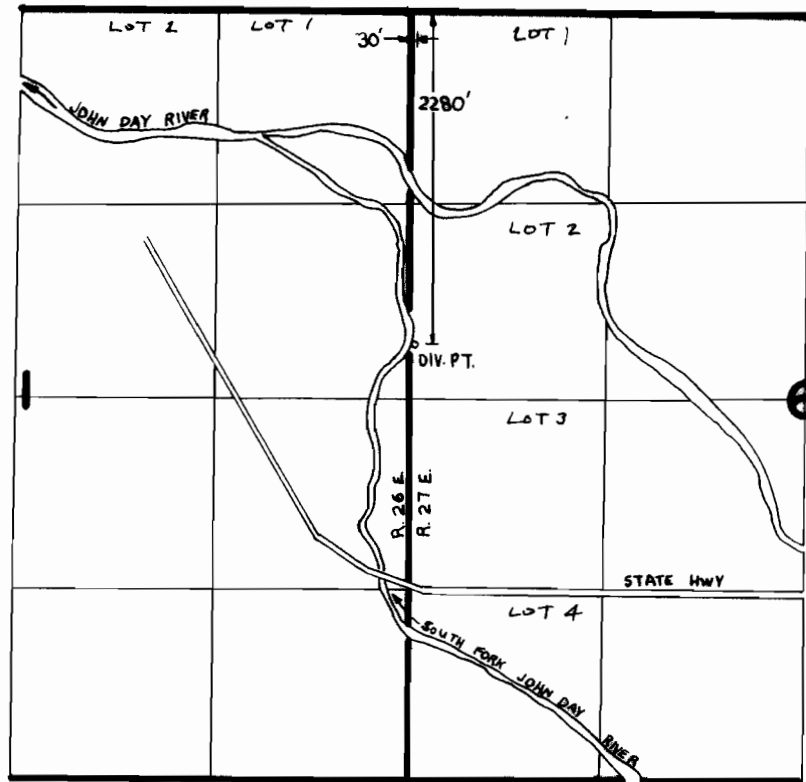


T. 13 S. R. 26 & 27 E. W. M.

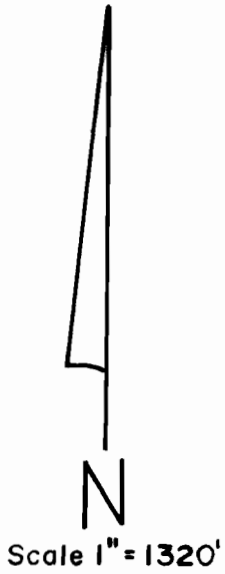

FINAL PROOF SURVEY
UNDER

TRANSFER 5407

IN NAME OF

RALPH GOODWIN

Surveyed April 7, 1986, by V. Church