


T.9 S. R.27 E. W.M.

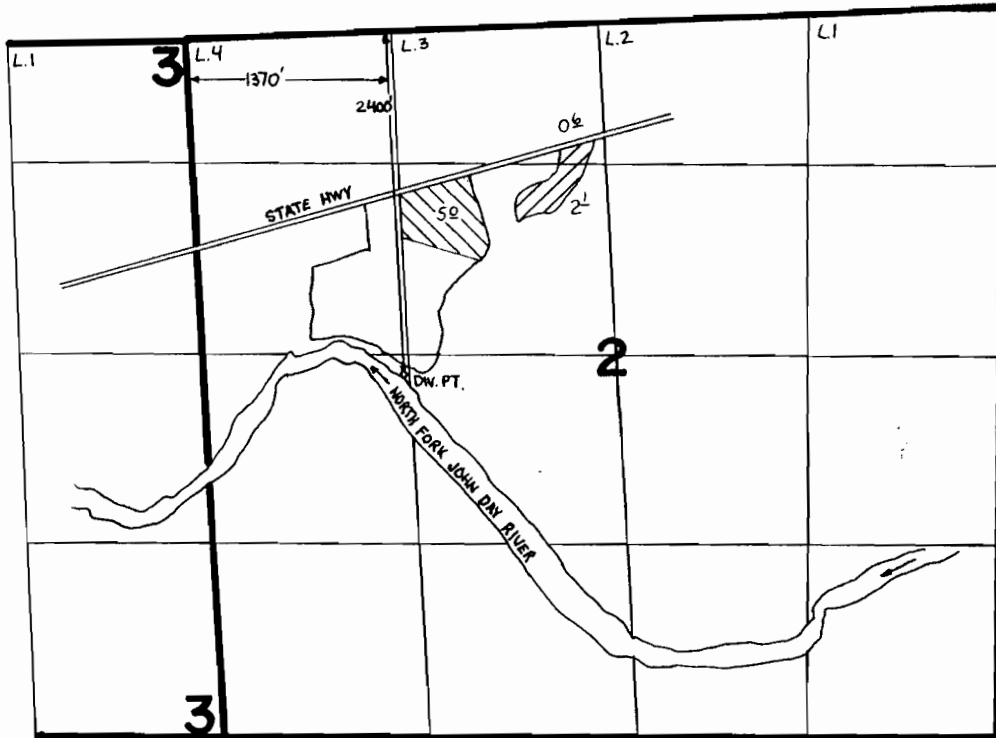

Scale 1" = 1320'



FINAL PROOF SURVEY

UNDER

TRANSFER 5402

TRANSFER 5403

IN NAME OF

LARRY WIRFS

Surveyed March 21, 1986, by V. Church.....