



T. 9 S. R. 27 E. W.M.

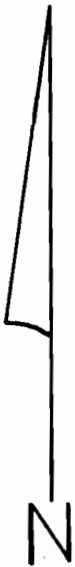

Scale 1" = 1320'

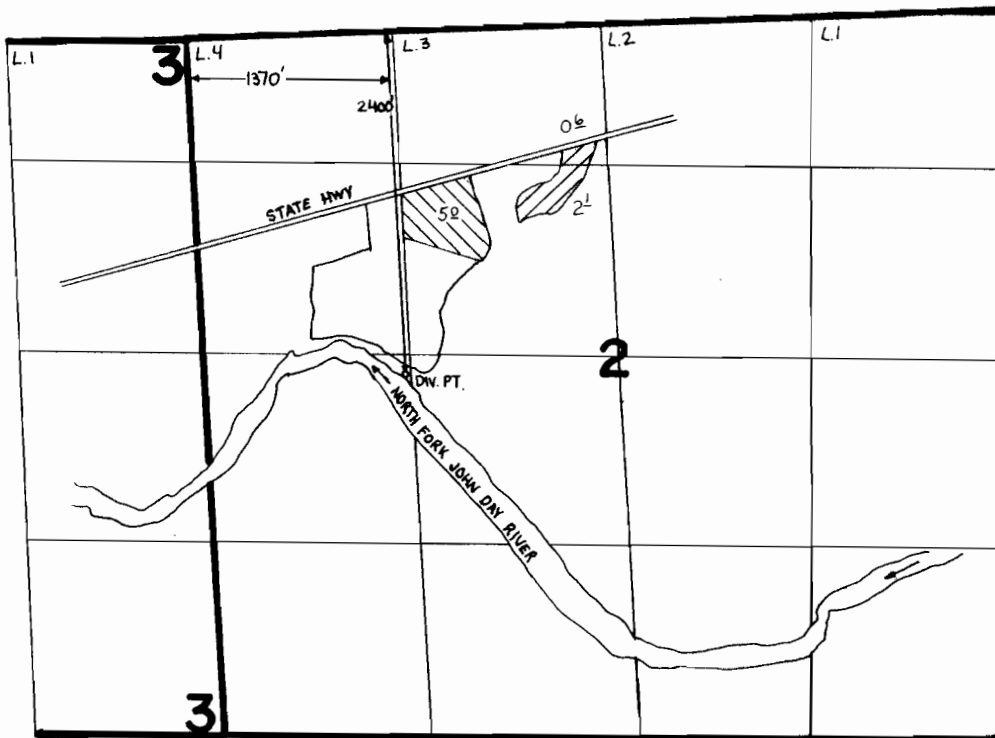

**FINAL PROOF SURVEY**

UNDER

**TRANSFER 5402**

**TRANSFER 5403**

IN NAME OF

**LARRY WIRFS**

Surveyed March 21, 1986, by V. Church.....