T. 34 S., R. 3 W., W.M.

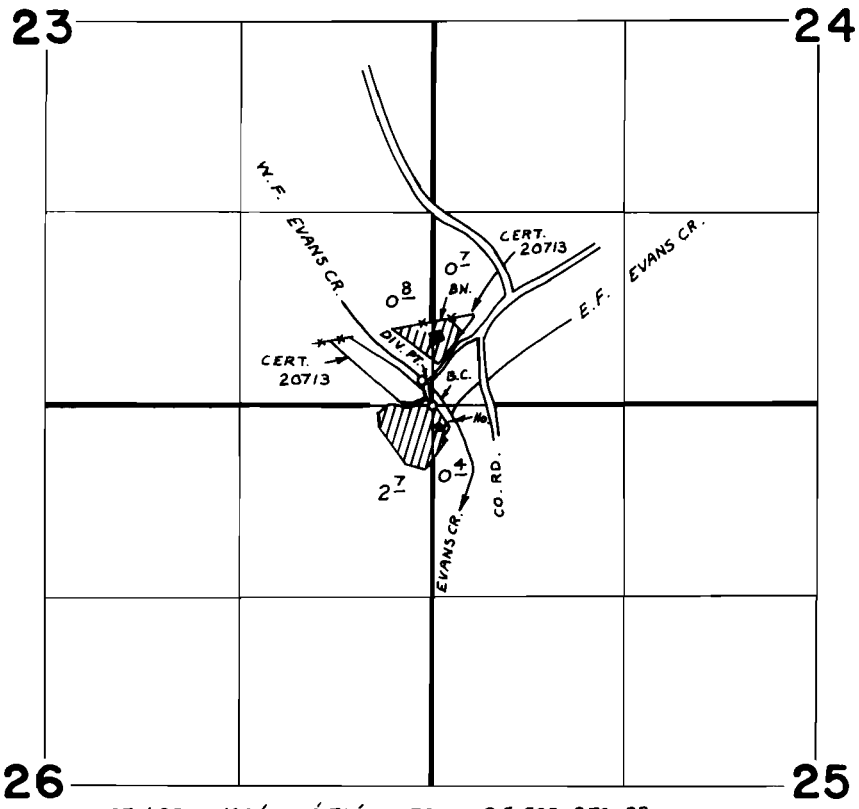

DIV. PT. LOC.: 160' N. & 70' W. FROM S.E. COR. SEC. 23

Scale 4" = 1 mile

FINAL PROOF SURVEY

UNDER

Application No. 51158... Permit No. 38664.....
IN NAME OF

THOMAS A. & ELLEN L. WALLACE

Surveyed Aug. 7,... 1980, by B. SUND.....

PTS-1980-14 A