


T.12S. R.5W. W.M.

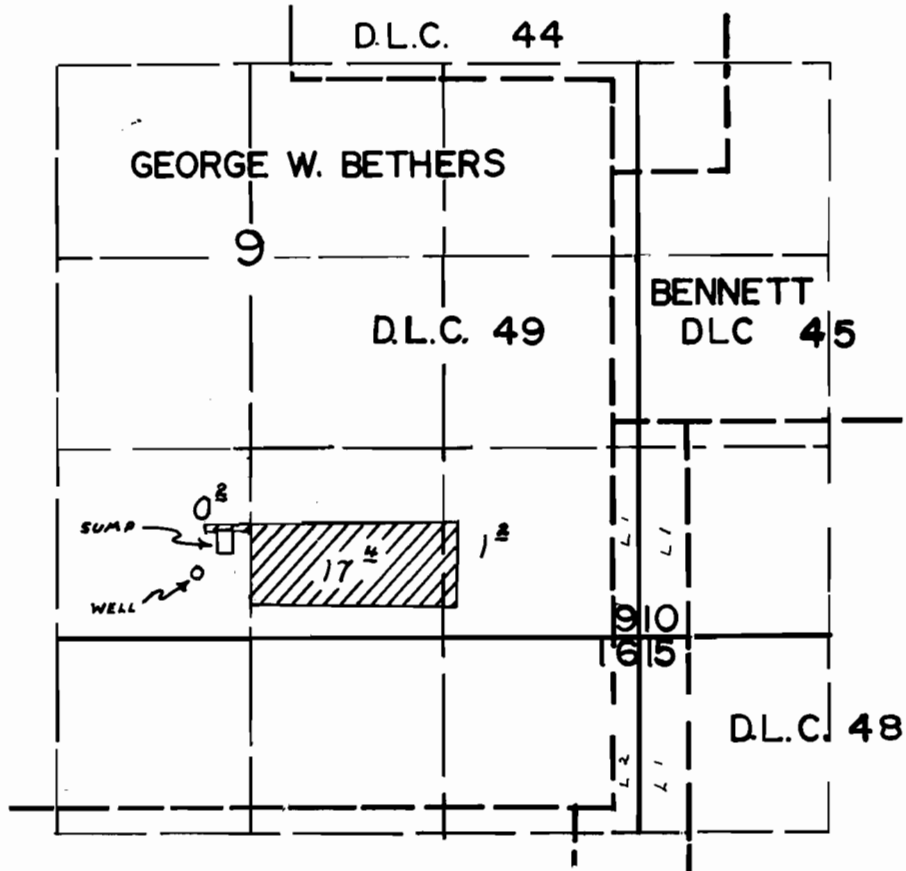

WELL LOC. 1000'S. & 2800'W FROM THE S.W. COR. BENNETT DLC 45

**FINAL PROOF SURVEY**  
UNDER

Application No. G-11124 Permit No. G-10256  
IN NAME OF

JOAN L. FORREST

Surveyed MAY. 6 1987, by J.M. WARREN