

5-1885
45
Spring
W. 1877

24

25

1/2-1903


5th Dam
1903

Ram 5th 1900

Ram
Dam 5th 1900

23

26

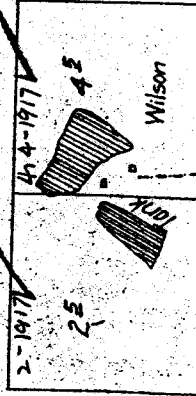

22

27