


T. 13S., R. 33E., W.M.

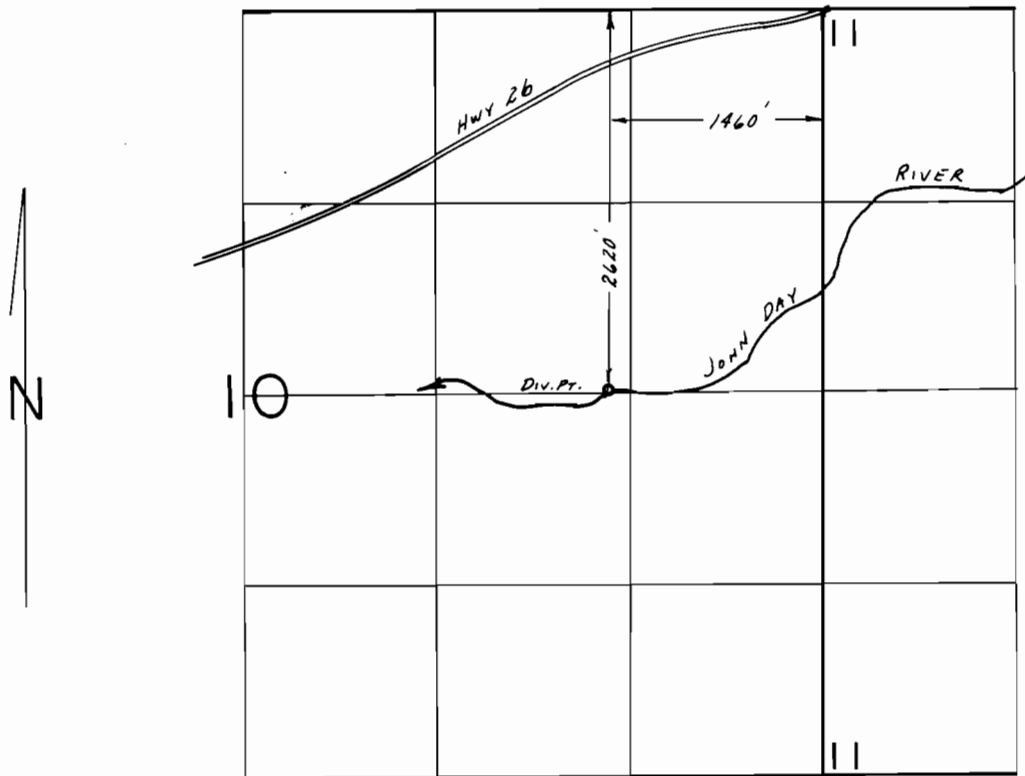

SCALE: 1" = 1320'

**FINAL PROOF SURVEY**  
UNDER

Transfer No. 5969

IN NAME OF

.....ELMWOOD RANCHES.....

Surveyed June 17... 1988., by V.L. CHURCH....