


T. 4 S., R. 1 W., W.M.

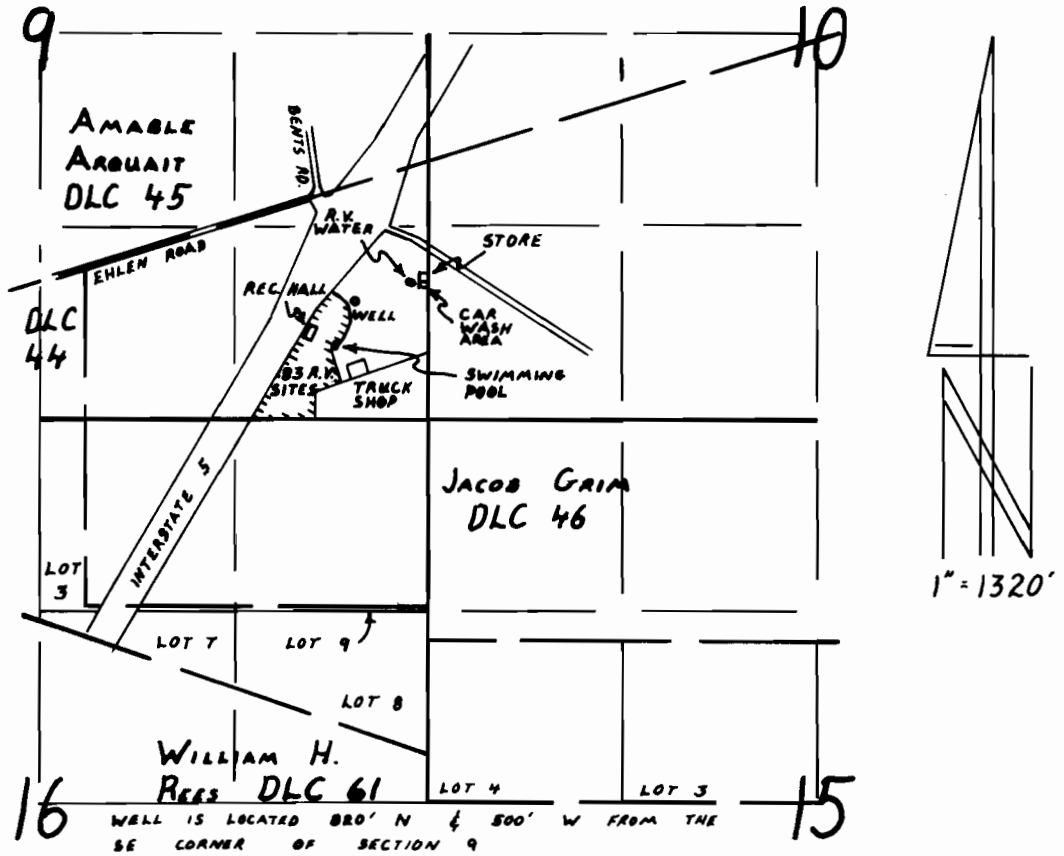

FINAL PROOF SURVEY

UNDER

Application No. G-10856 Permit No. G-10008
IN NAME OF

JACK ISBERG

Surveyed AUGUST 14, 1992, by R.W. Klassen