


T. 31 S., R. 1 W., W. M.

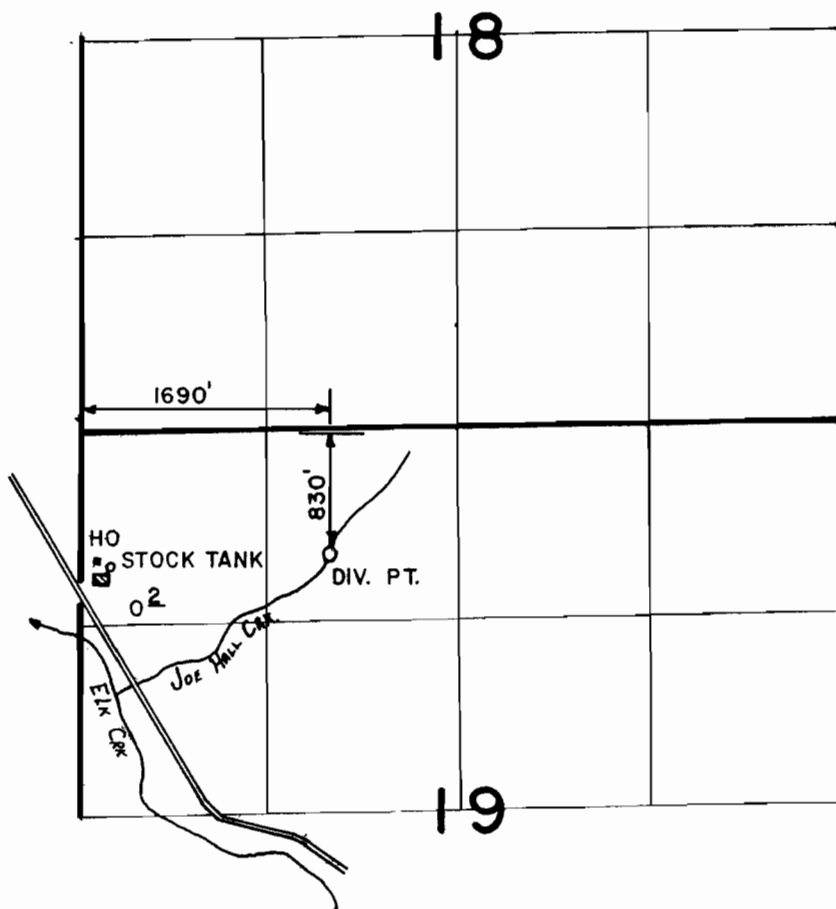

SCALE: 4" = 1 MILE

FINAL PROOF SURVEY
UNDER

Application No. 51862... Permit No. 39149.....
IN NAME OF

LARRY COCKRELL

Surveyed JUNE 21, 1988, by J. M. SCHMORDE