


T. 8 N., R. 6 W., W.M.

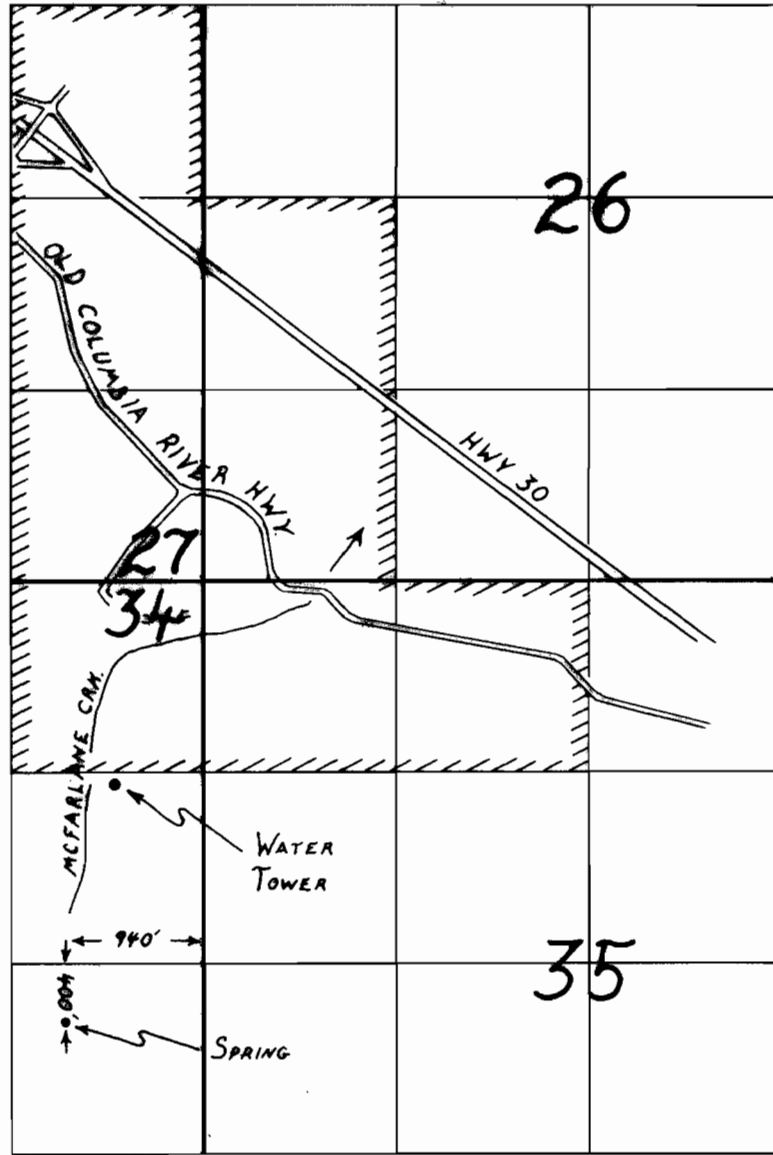

FINAL PROOF SURVEY

UNDER

Application No. 46756 Permit No. 43564
IN NAME OF

Wauna Water District

Surveyed May 24, 1994, by R.W. Klassen