


T. 21 S., R. 36 E., W.M.

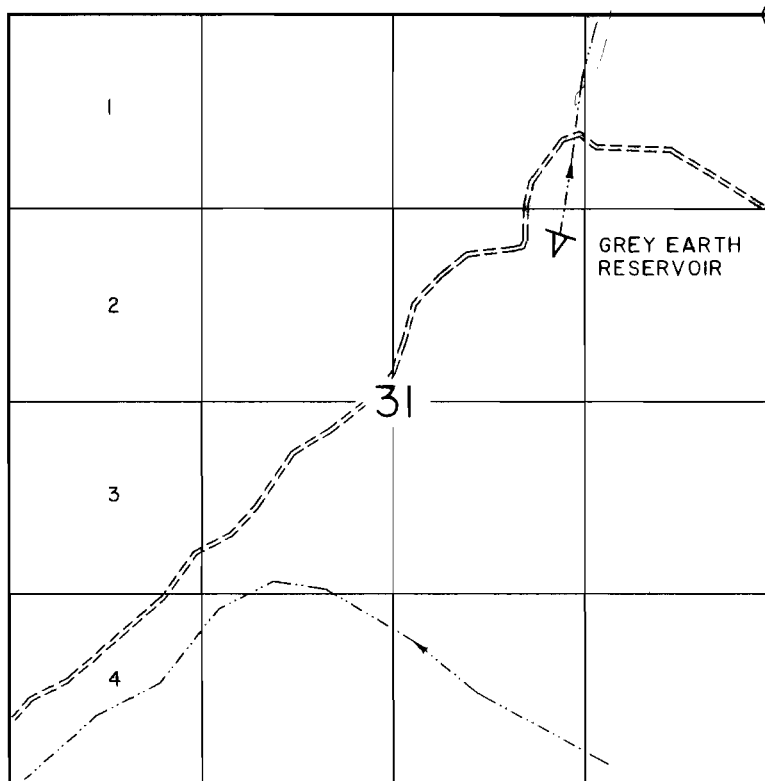

DIVERSION IS LOCATED
1525 FEET SOUTH AND
1480 FEET WEST OF THE
NE SECTION CORNER.


$$1'' = 1320'$$


FINAL PROOF MAP

IN NAME OF

UNITED STATES BUREAU OF LAND MANAGEMENT

APPLICATION NO. R-61378

PERMIT NO. R-10026

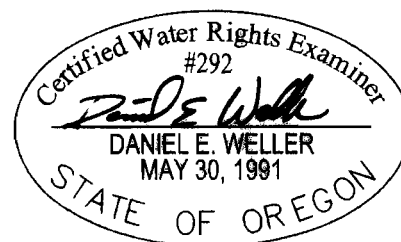

EXPIRES: JUNE 30, 2004

SURVEYED: MAY 2, 2001

THE PURPOSE OF THIS MAP IS FOR IDENTIFYING THE LOCATION OF THE WATER RIGHT ONLY AND IS NOT INTENDED TO PROVIDE LEGAL DIMENSIONS OR LOCATION OF PROPERTY OWNERSHIP LINES.

BLM PROJECT NO. 4947

U.S. BUREAU OF LAND MANAGEMENT-OSO
BRANCH OF CADASTRAL SURVEY

DWG: GREY EARTH

EXECUTED BY:
DANIEL E. WELLER, PLS, CWRE
P.O. BOX 2965
PORTLAND, OREGON 97208