


T. 4 S., R. 5 W., W.M.

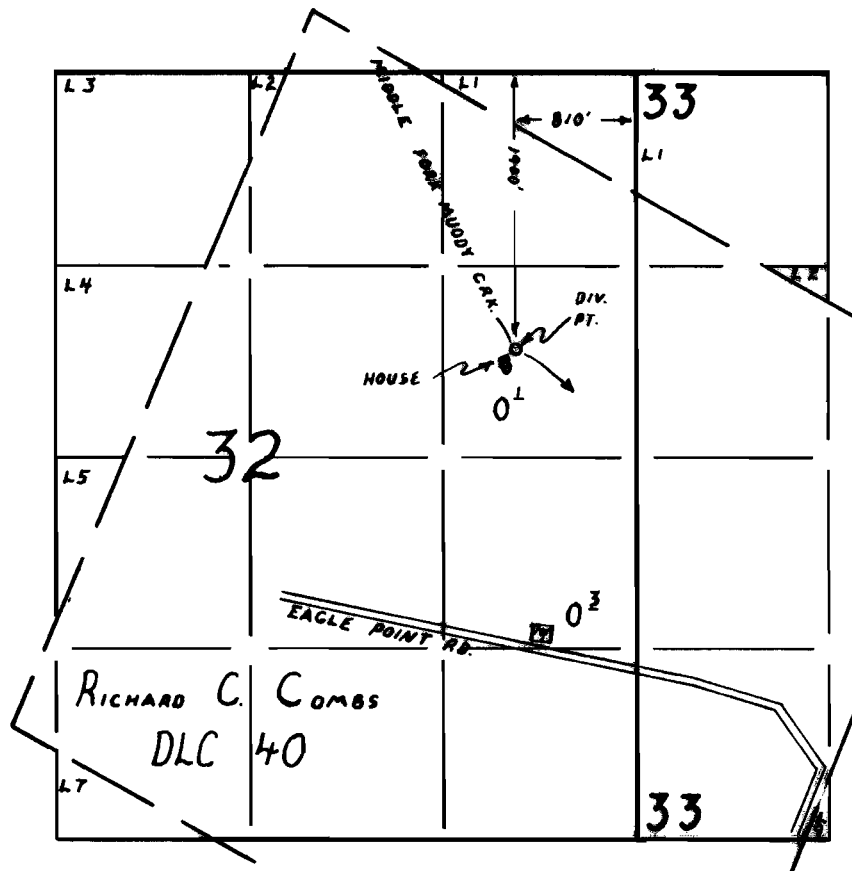

FINAL PROOF SURVEY

UNDER

Application No. 63487 Permit No. 47277
IN NAME OF

CARL CASWELL

Surveyed FEBRUARY 26, 1991, by R.W. Klassen