T. 6 S. R. 1 W. W. M.

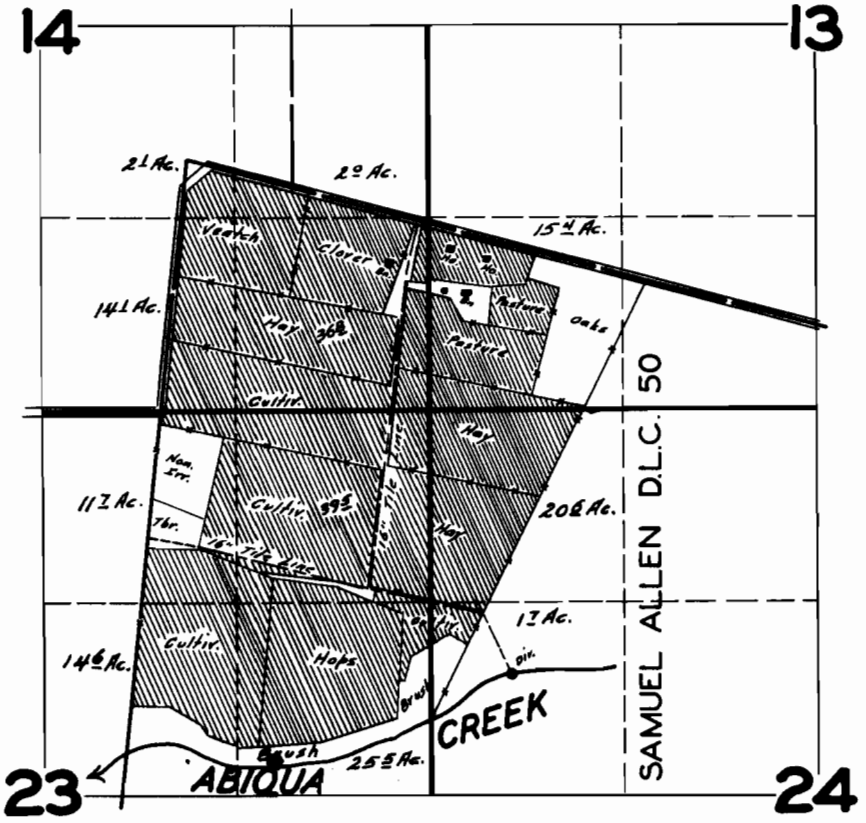

FINAL PROOF SURVEY

UNDER

Application No. 17937 **Permit No.** 13619

IN NAME OF

JOE J. WALKER

Surveyed JUNE 1 **1945**

1945-A