


T. 1 N., R. 2 E., W.M.

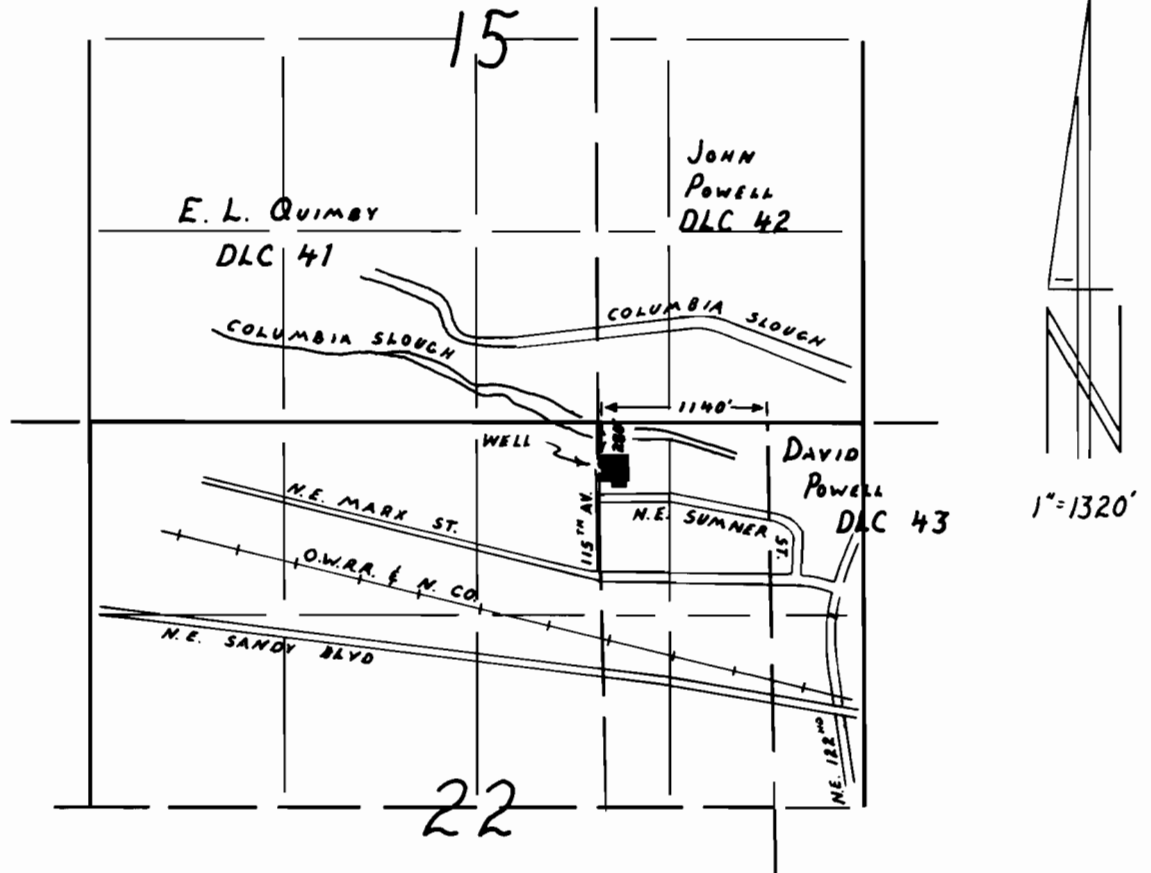

FINAL PROOF SURVEY

UNDER

Application No. G-11482 Permit No. G-10597

IN NAME OF

Continental Brass

Surveyed August 11, 1993, by R.W. Klassen