


T.10S.R.1 E.W.M.

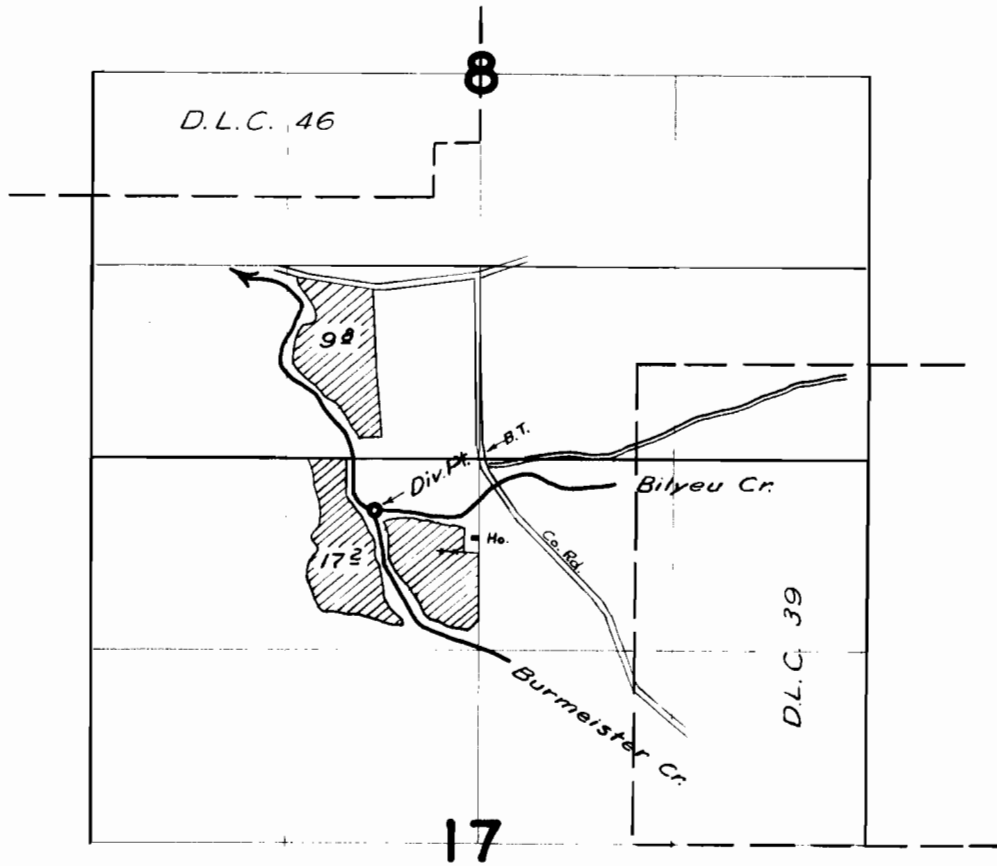

FINAL PROOF SURVEY UNDER

Application No. 25442 Permit No. 20010
IN NAME OF

ROY H. & KATHRYN BATES

Surveyed 1 July 1959, by M. Bish