
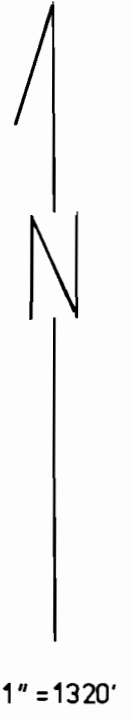


T. 12 S., R. 26 E., W. M.

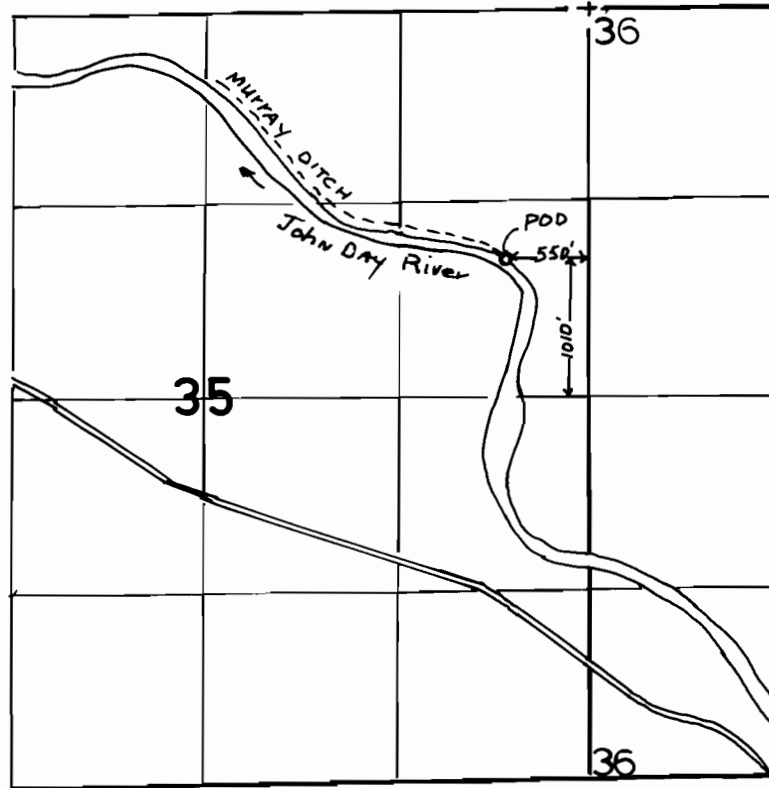

**FINAL PROOF SURVEY
UNDER**

TRANSFER NO. 5971
Application No. Permit No.
IN NAME OF
.....ALVIN AND MAGGIE BROWN.....
Surveyed 9-27..... 1999., by J.MILLER.....