


TOWNSHIP 9 SOUTH, RANGE 23 EAST, W.M.

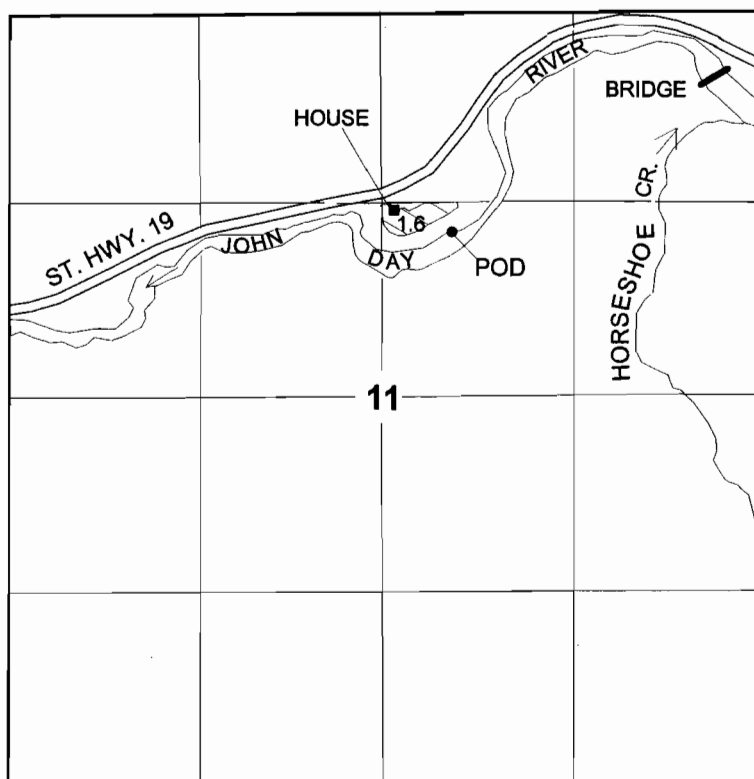

POD - 1500 FEET SOUTH AND 480 FEET EAST FROM THE NORTH 1/4 CORNER, SECTION 11.

FINAL PROOF SURVEY

UNDER
Application No. 64574 Permit No. 47336

IN THE NAME OF
WALTER H. AND SANDRA L. SPEER

Surveyed April 26, 2001 by June Miller

RECEIVED

DEC 23 2002

WATER RESOURCES DEPT.
SALEM, OREGON