
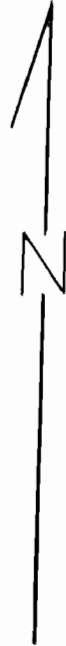


T.7 S., R 24 E., W.M.

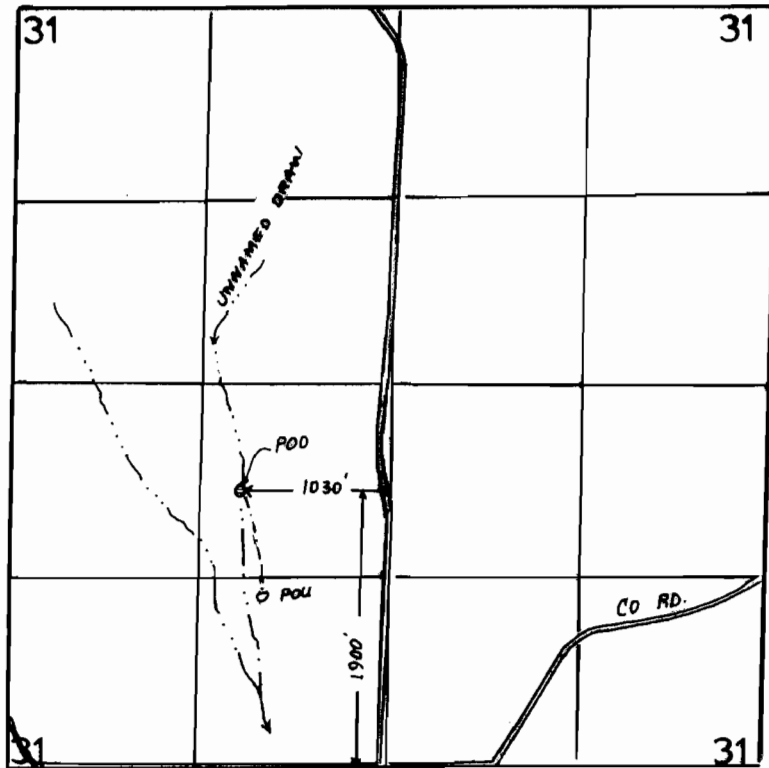

1" = 1320'

FINAL PROOF SURVEY
UNDER

Application No. 61677.. Permit No. 45748.....
IN NAME OF

.....
Surveyed 6-8..... 2000., by J. MILLER.....

RECEIVED

MAR 02 2001

WATER RESOURCES DEPT
SALEM, OREGON