



T. 4 S., R. 40 E., W. M.

-  PRIMARY
-  SUPP'L to C-66116
-  SUPP'L to C-6359

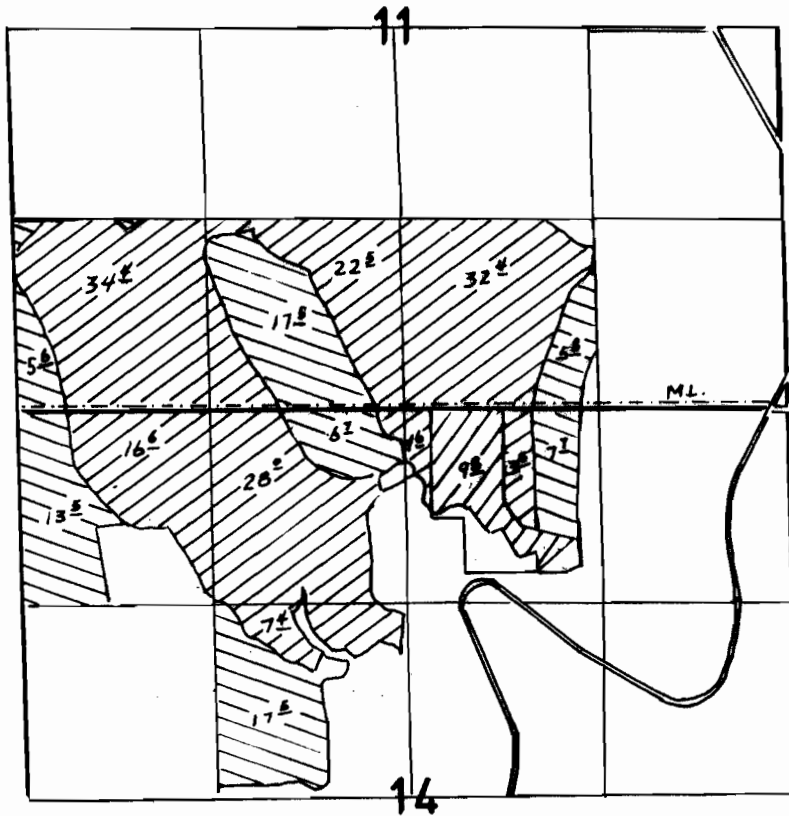

NE 1/4 SEC. 7
T. 4 S. R. 41 E., W. M.

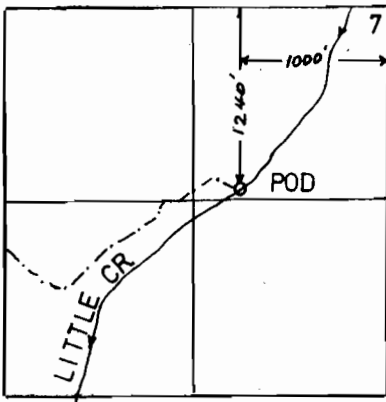

FINAL PROOF SURVEY UNDER

Application No. ~~65242~~... Permit No. ~~47884~~.....
IN NAME OF

.....ROBERT C. SHEEHY.....

Surveyed AUG. 11.... 1994... by J. MILLER.....