


# T.13S., R.32E., W.M.

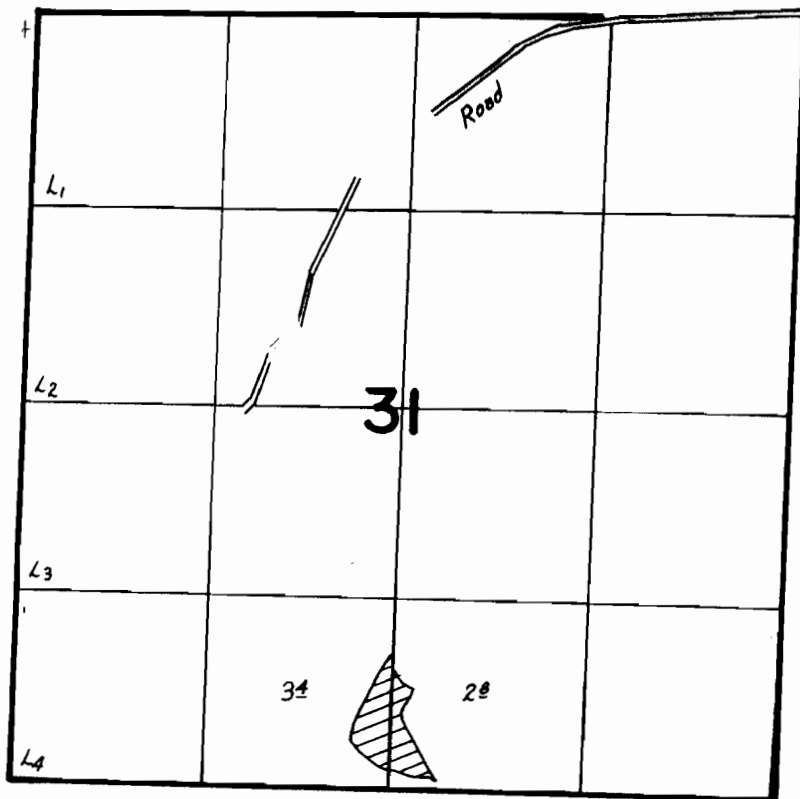

**FINAL PROOF SURVEY**  
UNDER

**TRANSFER 5394**

IN NAME OF

...CARL & BETTY JANE SHEEDY.....

Surveyed ...7-7..... 19.87., by ..Vern..Church.....



Scale: 1" = 1320'