


T. 3S., R. 4W., W. M.

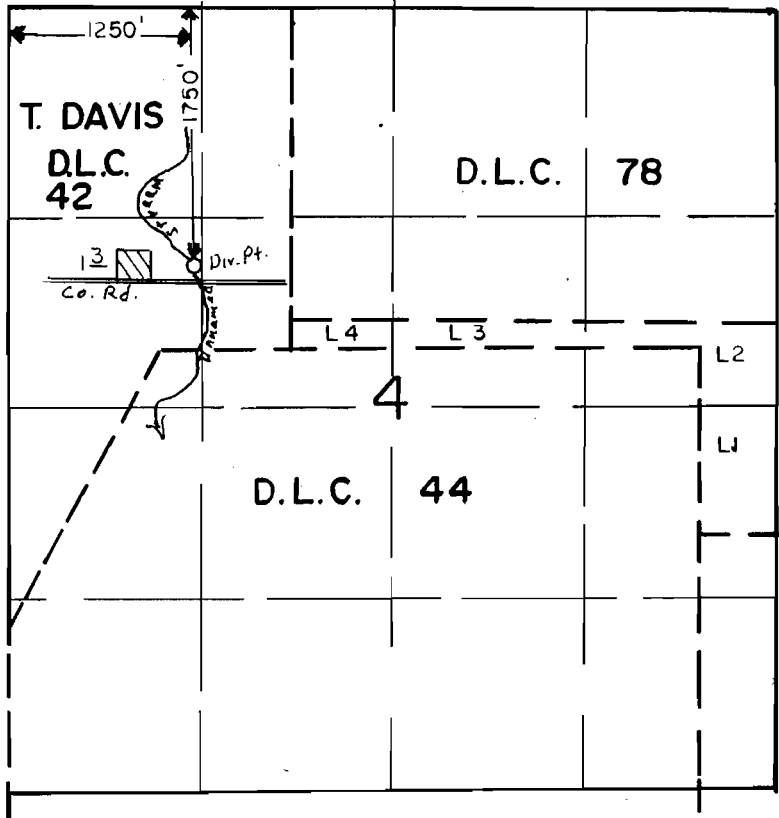

SCALE: 1" = 1320'

FINAL PROOF SURVEY
UNDER

Transfer No 5657

Application No. Permit No.
IN NAME OF

.....**SIMON**.....**NAGELY**.....

Surveyed **AUG. 5**..... 1987...., by **B. W. BISHOP**.....