


T.41 S., R.20 & 21 E., W.M.

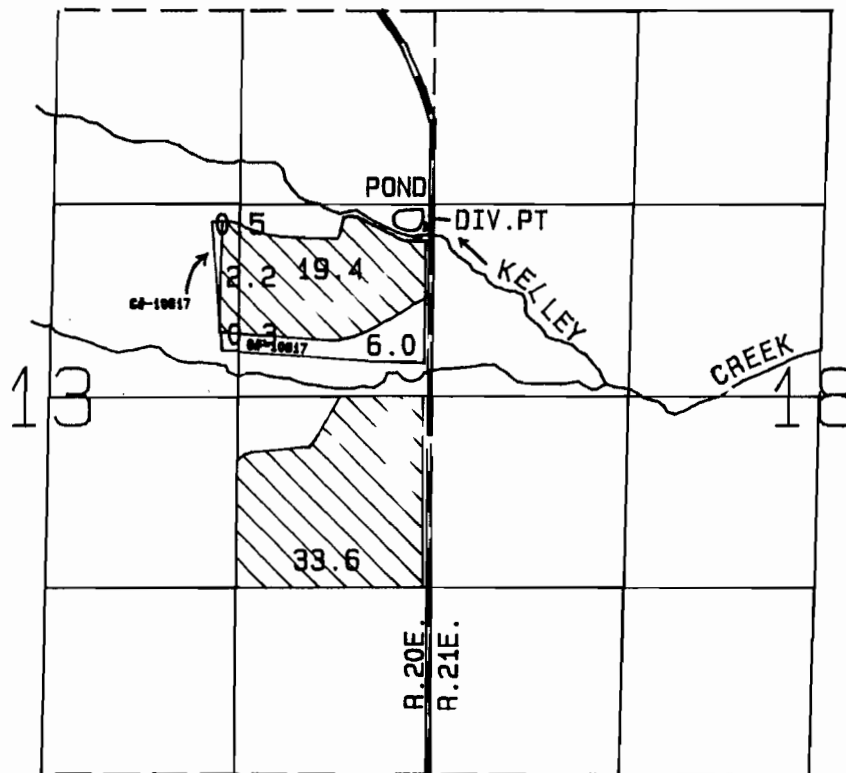

SCALE; 1 = 1320

DIV.PT. LOCATED 1090 FT. N. AND 100 FT. W. FROM E.1/4 COR. SEC. 13

FINAL PROOF SURVEY
UNDER

TRANSFER 5416
IN NAME OF
KELLY CREEK RANCH

Surveyed Oct. 15, 1987 By V.L. CHURCH

Photo: 379-1708 JCL